

Dennis Smith 733-7800

3.89 acres

SOUTHEASTERN DISTRICT HEALTH DEPARTMENT
INDIVIDUAL SEWAGE DISPOSAL INSTALLATION PERMIT

Permit No. _____ Contractor Design Construction of Id. Date 15 March 1976

Installation for Norton and Assoc. owners at Sec 16 T 6 S R 34
(Name) (Legal description of property)

Address of Installation on U.S. Hwy 30 - west of Por. between Hensup & Slaw
for E. J. Bartella, Elevators (Name) (Address)

No. Living Units 1 Bedrooms _____ People Served _____ Water Supply--Private _____ Public _____
Applicant is: Contractor Other _____

FNA _____ FARM HOME _____ VA _____ CONV. _____ EXISTING _____ NO. _____

Septic Tank 1000 gal. Perc. Rate 27 Min./in. Min. Depth to Ground Water _____ ft.

Effluent Disposal: Effective Area Required 250 sq. ft. Soil System: _____ Soil Profile _____
Field Drain Absorption Bed _____ Standard _____ Modified _____ Seepage Pit _____ Dimensions _____

Distance from Disposal Area to:
Property Lines: Front 10 ft. Back 10 ft. Side 10 ft. Dwelling Foundation 20 ft. Well 100 ft.

Surface Water NA ft. Nearest Neighbor's Well 100 ft. Plot Plan Submitted and Approved _____ Septic Tank _____ ft.

Remarks: Home sewer system inspected and approved before backfilling

Applicant: [Signature] Paid _____ Bill _____ No Fee _____

Address: _____ Permit Issued by William F. Maitland

INSPECTION: Septic Tank Size _____ Standpipe _____ Depth to Manhole _____

Distance from Septic Tank to: Dwelling Foundation _____ ft. Well _____ ft. Nearest Neighbor's Well _____ ft.

Effluent Disposal: Effective Area _____ sq. ft.
Field Drain _____ Absorption Bed _____ Standard _____ Modified _____ Seepage Pit _____ Dimensions _____

Pipe Size _____ No. of Lines _____ Length _____ Depth _____


Distance from Disposal Area to:
Property Lines: Front _____ ft. Back _____ ft. Side _____ ft. Dwelling Foundation _____ ft. Well _____ ft.

Surface Water _____ ft. Water Service Piping _____ ft. Depth to Gravel _____ ft. Nearest Neighbor's Well _____ ft.

Approved Not Approved _____ Inspected 5-21-76 by Tom Hopkins Installed by Bengal Const.
(Date)

Remarks _____

Applicant's sketch of house, proposed sewage layout and all adjacent wells (dimension between all components) --

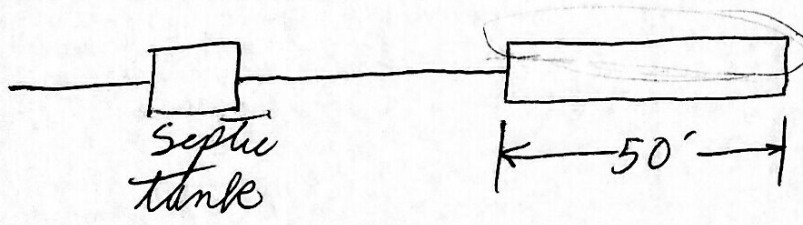

2 trenches 50' long and 2 1/2' wide with at least 6 feet of undisturbed earth between trenches.