

SOUTHEASTERN DISTRICT HEALTH DEPARTMENT
INDIVIDUAL SEWAGE DISPOSAL INSTALLATION PERMIT

20

Permit No. _____ Date 8/25/76
Installation for A. E. Chandler at Sec 4 T6S R34
(Name) (Legal description of property)

Address of Installation SEE APPLICATION

No. Living Units 1 Bedrooms 2 People Served 6 Water Supply--Private _____ Public Applicant is: Owner Contractor _____ Other _____
FHA _____ FARM HOME _____ VA _____ CONV. _____ EXISTING _____ NO. _____

Septic Tank 1000 gal. Perc. Rate 29 Min./in. Min. Depth to Ground Water _____ ft.

Effluent Disposal: Effective Area Required 540 sq. ft. Soil System: Soil Profile _____
Field Drain Absorption Bed _____ Standard Modified _____ Seepage Pit Dimensions 10' deep x 17' square

Distance from Disposal Area to:
Property Lines: Front 50 ft. Back 200 ft. Side 100 ft. Dwelling Foundation 20 ft. Well _____ ft.
Surface Water _____ ft. Nearest Neighbor's Well _____ ft. Plot Plan Submitted and Approved Septic Tank 10 ft.

Remarks: Have inspected before covering it up
Applicant Paid _____ Bill _____ No Fee

Address Rte 2 Box 246 Permit Issued by Fred Huffman

INSPECTION: Septic Tank Size 1000 Standpipe _____ Depth to Manhole 12"

Distance from Septic Tank to: Dwelling Foundation 10 ft. Well city ft. Nearest Neighbor's Well _____ ft.

Effluent Disposal: Effective Area 540 sq. ft.
Field Drain Absorption Bed _____ Standard _____ Modified _____ Seepage Pit _____ Dimensions 17' x 17'

Pipe Size _____ No. of Lines 2 Length 90 Depth 3' wide



Distance from Disposal Area to:
Property Lines: Front 210 ft. Back 10 ft. Side 210 ft. Dwelling Foundation 15 ft. Well _____ ft.
Surface Water _____ ft. Water Service Piping 750 ft. Depth to Gravel 2 ft. Nearest Neighbor's Well _____ ft.

Approved Not Approved Inspected 11-24-76 by Fred Huffman Installed by _____
(Date)


Remarks _____

Applicant's sketch of house, proposed sewage layout and all adjacent wells (dimension between all components) --

$$\begin{array}{r} 2 \\ 180 \\ \hline 540 \end{array}$$

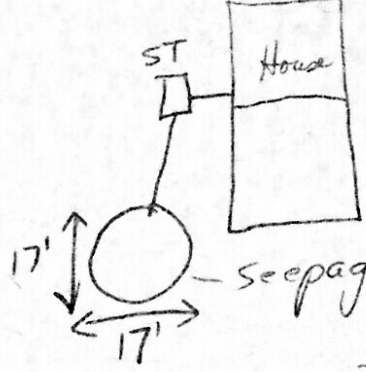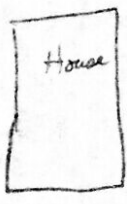

Change to 440 ft² required
Perc test redone to 18 min/ft
9-23-76 FH

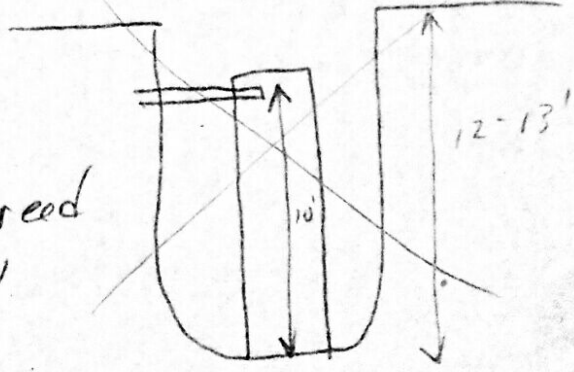

27 Sept - MR Chandler Agreed
To install Three - 50' x 3'
Tranches = 450 sq. ft.