

SOUTHEASTERN DISTRICT HEALTH DEPARTMENT  
INDIVIDUAL SEWAGE DISPOSAL INSTALLATION PERMIT

6 34 22

elo

By 4:30 Today if possible  
Permit No. \_\_\_\_\_ Date 7 June 1977  
Installation for Champion Construction Supply - Warehouse at \_\_\_\_\_  
(Name) (Legal description of property)  
Address of Installation Cut Garretway - Turn left just before underground  
No. Living Units \_\_\_\_\_ Bedrooms \_\_\_\_\_ People Served \_\_\_\_\_ Water Supply - Private \_\_\_\_\_ Public \_\_\_\_\_ Applicant is: Owner \_\_\_\_\_ Contractor  Other \_\_\_\_\_  
FHA \_\_\_\_\_ FARM HOME \_\_\_\_\_ VA \_\_\_\_\_ CONV. \_\_\_\_\_ EXISTING \_\_\_\_\_ NO. mini-warehouses

Septic Tank 1000 gal.  
Effluent Disposal: Effective Area Required 500 sq. ft. Soil System: Perc. Rate \_\_\_\_\_ Min./in. Min. Depth to Ground Water \_\_\_\_\_ ft.  
Soil Profile fine sand under 3' topsoil  
Field Drain \_\_\_\_\_ Absorption Bed \_\_\_\_\_ Standard \_\_\_\_\_ Modified \_\_\_\_\_ Seepage Pit  Dimensions \_\_\_\_\_

Distance from Disposal Area to:  
Property Lines: Front \_\_\_\_\_ ft. Back \_\_\_\_\_ ft. Side \_\_\_\_\_ ft. Dwelling Foundation \_\_\_\_\_ ft. Well \_\_\_\_\_ ft.  
Surface Water \_\_\_\_\_ ft. Nearest Neighbor's Well \_\_\_\_\_ ft. Plot Plan Submitted and Approved \_\_\_\_\_ Septic Tank \_\_\_\_\_ ft.

Remarks: 20 people max x 35 gal = 700 gal  
Applicant Al Haldan Manager Paid \_\_\_\_\_ Bill \_\_\_\_\_ No Fee \_\_\_\_\_  
Address \_\_\_\_\_ Permit Issued by HARRY Fungeon

INSPECTION: Septic Tank Size 1000 Standpipe 4 ft Depth to Manhole ground level  
Distance from Septic Tank to: Dwelling Foundation 10 ft. Well 250 ft. Nearest Neighbor's Well 50 ft.  
Effluent Disposal: Effective Area 500 sq. ft.  
Field Drain \_\_\_\_\_ Absorption Bed \_\_\_\_\_ Standard  Modified \_\_\_\_\_ Seepage Pit  Dimensions 22 x 25 x 17  
Pipe Size 4" No. of Lines NA Length \_\_\_\_\_ Depth \_\_\_\_\_

Distance from Disposal Area to:  
Property Lines: Front 210 ft. Back 210 ft. Side 20 ft. Dwelling Foundation 20 ft. Well 2100 ft.  
Surface Water 250 ft. Water Service Piping 225 ft. Depth to Gravel 3 ft. Nearest Neighbor's Well NA ft.  
Approved  Not Approved \_\_\_\_\_ Inspected 15 Aug 77 by Jackie Bennett Installed by Porter  
(Date)


Remarks: Approved on condition that lines to septic tank and seepage pit cover and manhole cover are grouted.  
Applicant's sketch of house, proposed sewage layout and all adjacent wells (dimension between all components) --

MINIMUM size of seepage pit to be as follows:

10 feet below inlet | OR | 8 ft below inlet  
16. feet diameter | | 20 ft. diameter

Existing 1000 gallon septic tank is to be relocated since outlet currently 180° in wrong direction.

Nothing less THAN schedule 40 pipe is to be used. CAST IRON into and out of septic tank.

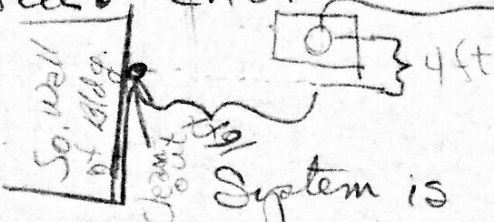

System is to be installed in complete compliance with