

SOUTHEASTERN DISTRICT HEALTH DEPARTMENT  
INDIVIDUAL SEWAGE DISPOSAL INSTALLATION PERMIT

110

Permit No. \_\_\_\_\_ Date May 15, 1977  
 Installation for Clifford Traughber at N 1/2 corner on east line of Sec 8 T. 65 R. 34E  
(Name) (Legal description of property)  
 Address of Installation 1/4 mi South of Philitia - Chubbuck Rd intersection on W side of road  
 No. Living Units 1 Bedrooms 4 People Served 3 Water Supply--Private  Public \_\_\_\_\_ Applicant is: Owner  Contractor \_\_\_\_\_ Other \_\_\_\_\_  
 FHA \_\_\_\_\_ FARM HOME \_\_\_\_\_ VA \_\_\_\_\_ CONV.  EXISTING \_\_\_\_\_ NO. \_\_\_\_\_  
 Septic Tank 1000 gal. Perc. Rate 41 Min./in. Min. Depth to Ground Water 40 ft.  
 Effluent Disposal: Effective Area Required 240-280 sq. ft. Soil System: Soil Profile gravel at 5'  
 Field Drain \_\_\_\_\_ Absorption Bed \_\_\_\_\_ Standard \_\_\_\_\_ Modified \_\_\_\_\_ Seepage Pit  Dimensions 8' x 11'


Distance from Disposal Area to:  
 Property Lines: Front 10 ft. Back 10 ft. Side 10 ft. Dwelling Foundation 20 ft. Well 100 ft.  
 Surface Water 100 ft. Nearest Neighbor's Well 100 ft. Plot Plan Submitted and Approved  Septic Tank 6 ft.

Remarks: \_\_\_\_\_  
 Applicant Clifford Traughber Paid \_\_\_\_\_ Bill \_\_\_\_\_ No Fee   
 Address 46 Mountain Dr. Pocatello Permit Issued by Jack Pappas

INSPECTION: Septic Tank Size 1000 gal Standpipe 4 ft Depth to Manhole 2 ft  
 Distance from Septic Tank to: Dwelling Foundation 20 ft. Well \_\_\_\_\_ ft. Nearest Neighbor's Well \_\_\_\_\_ ft.  
 Effluent Disposal: Effective Area 400 sq. ft.  
 Field Drain \_\_\_\_\_ Absorption Bed \_\_\_\_\_ Standard \_\_\_\_\_ Modified \_\_\_\_\_ Seepage Pit  Dimensions 8' x 16'  
 Pipe Size \_\_\_\_\_ No. of Lines \_\_\_\_\_ Length \_\_\_\_\_ Depth \_\_\_\_\_

Distance from Disposal Area to:  
 Property Lines: Front 25 ft. Back 25 ft. Side 25 ft. Dwelling Foundation 30 ft. Well >100 ft.  
 Surface Water 2300 ft. Water Service Piping 250 ft. Depth to Gravel 3-4 ft. Nearest Neighbor's Well >100 ft.  
 Approved  Not Approved  Inspected 10 Aug 77 By Jack Pappas Installed by Howard Zuber Empire Constr.

Remarks Septic Tank is placed on edge of seepage pit; also  
sewer line to tank needs to be re-grouted.  
 Applicant's sketch of house, proposed sewage layout and all adjacent wells (dimension between all components) --

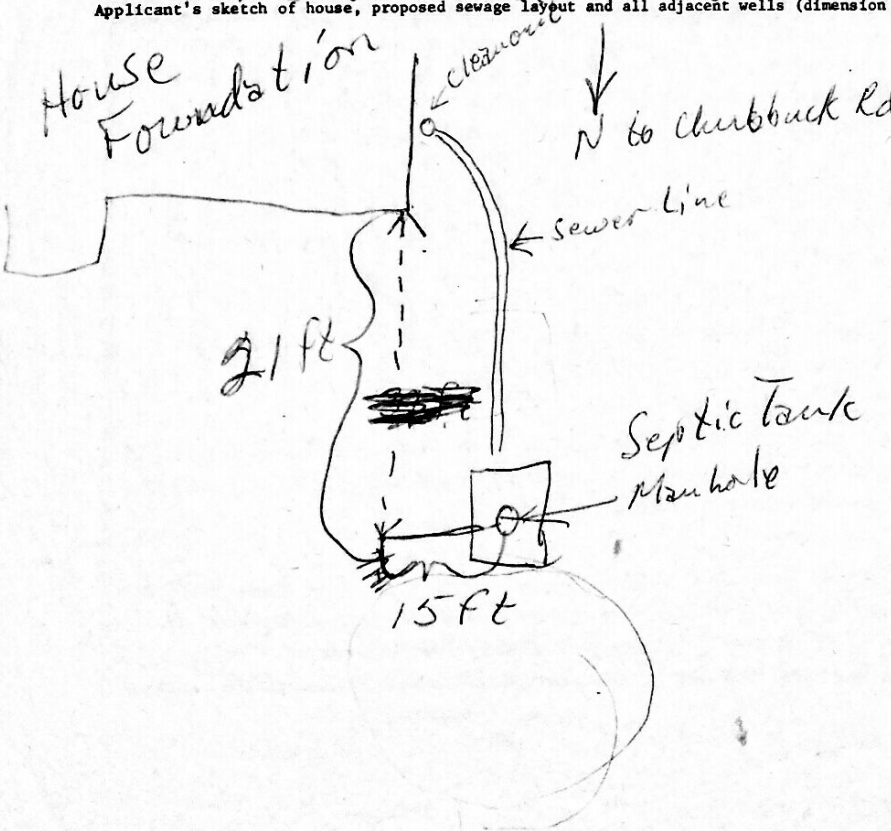

System was re-inspected  
 10 Aug 77. Septic Tank  
 was moved 18 ft  
 closer to the house.  
 From 39 ft away to  
 21 ft away. It was  
 freshly grouted.  
 System now meets  
 standards and is  
 approved. Jack B.