

SOUTHEASTERN DISTRICT HEALTH DEPARTMENT
INDIVIDUAL SEWAGE DISPOSAL INSTALLATION PERMIT

Permit No. _____ Date 5/8/78 updated 7-31-80
Installation for Carl D. Curtis at NE 1/4 SW 1/4 Sec. 21, Twp. 6S, Rng. 34E.
(Name) (Legal description of property)

Address of Installation FACEE Mtn DRIVE - NORTH SIDE OF ROAD

No. Living Units 1 Bedrooms 4 People Served 7 Water Supply--Private X Public _____
Applicant is: Owner X Contractor _____ Other _____
FHA _____ FARM HOME _____ VA _____ CONV. X EXISTING _____ NO. _____

Septic Tank ~~1000~~ gal. 1000 gallon 9 Perc. Rate 12 Min./in. Min. Depth to Ground Water _____ ft.
Effluent Disposal: Effective Area Required 875 sq. ft. Soil System: _____ Soil Profile _____
Field Drain ✓ Absorption Bed _____ Standard ✓ Modified _____ Seepage Pit _____ Dimensions _____

Distance from Disposal Area to:
Property Lines: Front 710 ft. Back 710 ft. Side 710 ft. Dwelling Foundation 20 ft. Well 100 ft.
Surface Water 150 ft. Nearest Neighbor's Well 7100 ft. Plot Plan Submitted and Approved ✓ Septic Tank 10 ft.

Remarks: DO NOT BACKFILL WITHOUT PRIOR INSPECTION


Applicant Carl D. Curtis Paid _____ Bill _____ No Fee ✓
Address _____ Permit Issued by TOM HOPKINS

INSPECTION: Septic Tank Size 1000 Standpipe 2' Depth to Manhole 2' will be graded down
Distance from Septic Tank to: Dwelling Foundation _____ ft. Well _____ ft. Nearest Neighbor's Well _____ ft.
Effluent Disposal: Effective Area 900 sq. ft.
Field Drain X Absorption Bed _____ Standard _____ Modified _____ Seepage Pit _____ Dimensions 3 lines 100' x 3' wide
Pipe Size _____ No. of Lines _____ Length _____ Depth _____

Distance from Disposal Area to:
Property Lines: Front 710 ft. Back 710 ft. Side >10 ft. Dwelling Foundation 20 ft. Well 7100 ft.
Surface Water NA ft. Water Service Piping 750 ft. Depth to Gravel 5 ft. Nearest Neighbor's Well 7100 ft.
Approved X Not Approved _____ Inspected 11/13/80 by Jed Huffman Installed by Richard Nelson
(Date)

Remarks _____

Applicant's sketch of house, proposed sewage layout and all adjacent wells (dimension between all components) --

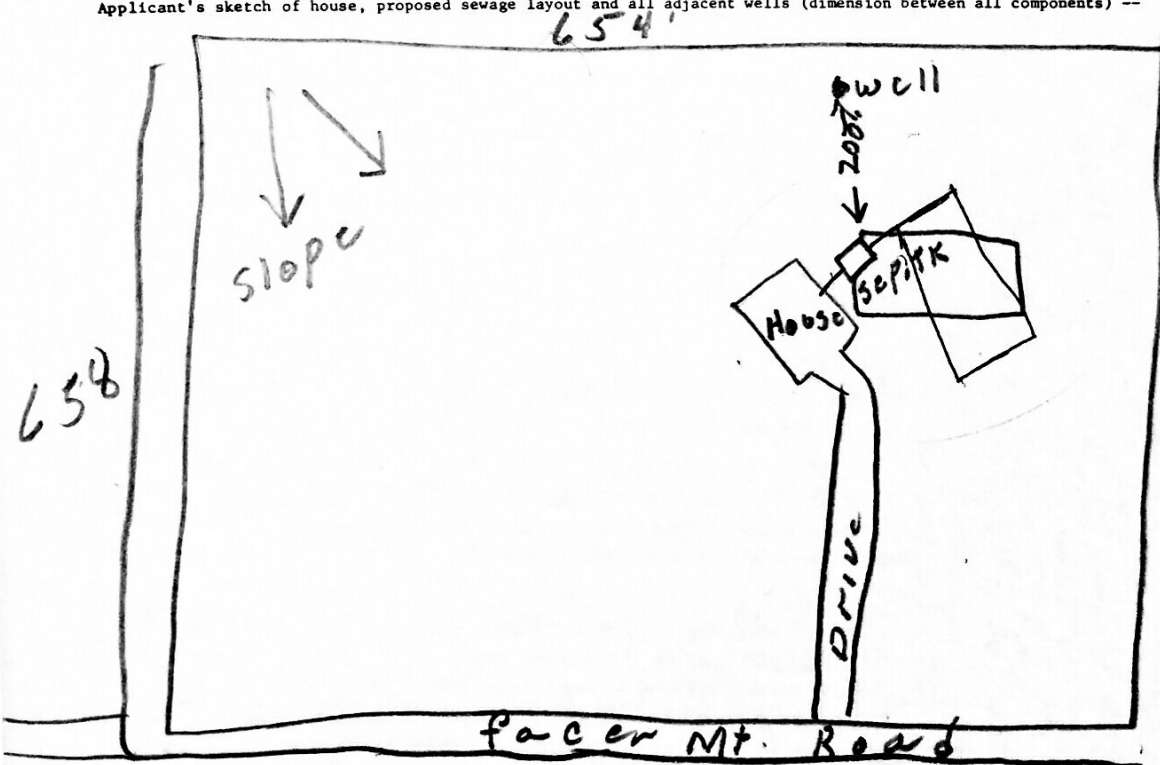

Reference: RULES AND REGULATIONS FOR INDIVIDUAL AND SUBSURFACE SEWAGE DISPOSAL SYSTEMS
Idaho Department of Health, Environmental Improvement Division, August 1971