

SOUTHEASTERN DISTRICT HEALTH DEPARTMENT  
INDIVIDUAL SEWAGE DISPOSAL INSTALLATION PERMIT

523-9080

ll0

Permit No. \_\_\_\_\_ Date 4-78  
 Installation for Dennis Madden at T. 6, S. Range 34 E. B. M. 19 a.  
(Name) (Legal description of property)  
 Address of Installation Rt 1 Tank Farm Rd. Pocatello Idaho  
 No. Living Units 2 Bedrooms 4 People Served 4 Water Supply—Private  Public   
Total Total Applicant is: Owner  Contractor  Other   
 FHA  FARM HOME  VA  CONV.  EXISTING  NO.

Septic Tank 1000 gal. Perc. Rate 1 Min./in. Min. Depth to Ground Water \_\_\_\_\_ ft.  
 Effluent Disposal: Effective Area Required 340 sq. ft. Soil System: \_\_\_\_\_ Soil Profile \_\_\_\_\_  
 Field Drain  Absorption Bed \_\_\_\_\_ Standard  Modified \_\_\_\_\_ Seepage Pit \_\_\_\_\_ Dimensions 2 1/2' x 50'  
Interconnected

Distance from Disposal Area to:  
 Property Lines: Front 110 ft. Back 110 ft. Side 110 ft. Dwelling Foundation 20 ft. Well 100 ft. 98'  
 Surface Water 700 ft. Nearest Neighbor's Well 800 ft. Plot Plan Submitted and Approved  Septic Tank 10 ft.

Remarks: Do Not Back Fill Without Prior Notice  
 Applicant  Dennis Madden Paid \_\_\_\_\_ Bill \_\_\_\_\_ No Fee   
 Address Rt 1 Tank Farm Rd. Permit Issued by Jack E. Rowland


INSPECTION: Septic Tank Size 1000 Standpipe \_\_\_\_\_ Depth to Manhole \_\_\_\_\_  
 Distance from Septic Tank to: Dwelling Foundation see diagram below ft. Well \_\_\_\_\_ ft. Nearest Neighbor's Well \_\_\_\_\_ ft.

Effluent Disposal: Effective Area \_\_\_\_\_ sq. ft.  
 Field Drain \_\_\_\_\_ Absorption Bed \_\_\_\_\_ Standard \_\_\_\_\_ Modified \_\_\_\_\_ Seepage Pit \_\_\_\_\_ Dimensions \_\_\_\_\_  
 Pipe Size \_\_\_\_\_ No. of Lines \_\_\_\_\_ Length \_\_\_\_\_ Depth \_\_\_\_\_

Distance from Disposal Area to:  
 Property Lines: Front \_\_\_\_\_ ft. Back \_\_\_\_\_ ft. Side \_\_\_\_\_ ft. Dwelling Foundation \_\_\_\_\_ ft. Well \_\_\_\_\_ ft.  
 Surface Water \_\_\_\_\_ ft. Water Service Piping \_\_\_\_\_ ft. Depth to Gravel \_\_\_\_\_ ft. Nearest Neighbor's Well \_\_\_\_\_ ft.

Approved \_\_\_\_\_ Not Approved  Inspected 4/11/78 by Ferguson Installed by Self  
(Date)  
 Remarks: sewer line above water line

Applicant's sketch of house, proposed sewage layout and all adjacent wells (dimension between all components)

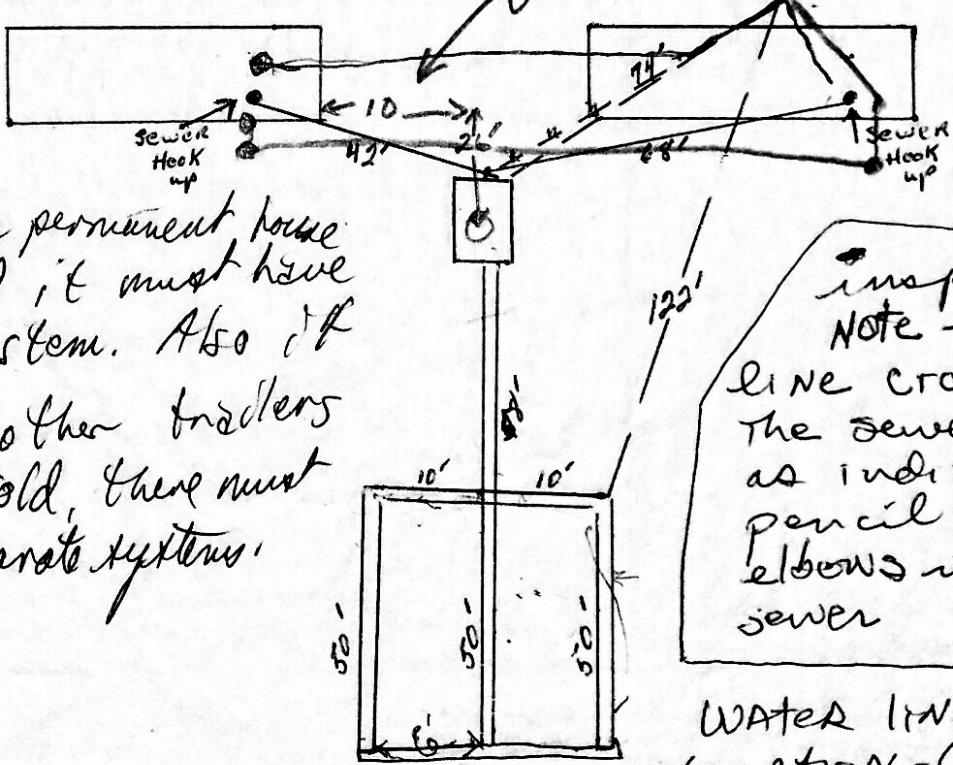

Should a permanent house be constructed it must have its own system. Also if one or the other tractors or lots be sold, there must then be separate systems.

inspection.  
 NOTE - WATER LINE CROSSES UNDER THE SEWER LINE AS INDICATED IN PENCIL - THE ELBOWS IN THE BLDG SEWER

WATER LINE CHANGED LOCATION - (Red) TO ELIMINATE CROSS OVER