

JURISDICTION
300

SOUTHEASTERN DISTRICT HEALTH DEPARTMENT
465 MEMORIAL DRIVE POCATELLO, ID

G.W., G.W
FEE PD Y N
PERMIT # 18096

TRAVEL TIME: 30 1 1
INSPECTION TIME: 30 1 1

***APPLICATION AND PERMIT VALID FOR ONE YEAR FROM DATE OF ISSUANCE

NAME Rodney Rupp		PHONE 237-3144	PROPERTY ADDRESS Buffalo Rd.		
MAILING ADDRESS: STREET/PO BOX 5597		LEGAL DESCRIPTION: LOT SIZE (ACRES) 1 1/4 SECTION NW SECTION 2 TOWNSHIP 6S RANGE 34E8M			
CITY Chubbuck		LOT # _____ BLOCK # _____ SUBDIVISION _____			
STATE ID		ZIP 83202	PARCEL # R3853002000 FROM TAX ASSESSOR'S OFFICE		
SEPTIC TANK SIZE 1000 gal.	EST TYPE 232	EFFECTIVE DISPOSAL AREA 667 SQ. FT.	SOIL TYPE B2	MAXIMUM DEPTH BELOW GROUND SURFACE 4 feet	# BEDROOMS 4

INSTALLATION MUST BE BY LICENSED SEWER INSTALLER OR HOME/LANDOWNER

EHS SIGNATURE <i>Steve J. [Signature]</i>	EHS # 64	APPLICANT SIGNATURE <i>Rodney Rupp</i>	DATE 8-13-93
REMARKS			

INSPECTION


THE DISTRICT HEALTH DEPARTMENT SHALL BE NOTIFIED OF INSTALLATION 48 HOURS PRIOR TO INSTALLATION

SEPTIC TANK SIZE 1000 gal.	STANDPIPE: () YES () NO	MANHOLE DEPTH 14"	DEPTH BELOW GROUND SURFACE 40"	ROCK UNDER PIPE 6"
EFFECTIVE DISPOSAL AREA 713 SQ. FT.	INSTALLATION APPROVED <input checked="" type="checkbox"/> DISAPPROVED <input type="checkbox"/>	INSTALLER BRYANT MILES		INSTALLER # 920
EHS SIGNATURE <i>[Signature]</i>	DATE 9/17/93	EHS # 61		
REMARKS				


WATER SYSTEM

PLANS APPROVED YES <input checked="" type="checkbox"/> NO <input type="checkbox"/>	SAMPLE COLLECTED BY	DATE	STATE LAB INDICATES INTESTINAL BACTERIA WERE _____ WERE NOT _____ FOUND
MIN. DISTANCES PER STANDARDS/REGS YES <input checked="" type="checkbox"/> NO <input type="checkbox"/>	CHEMICAL PARAMETERS TESTED WITHIN LIMITS YES <input type="checkbox"/> NO <input type="checkbox"/>		SYSTEM PUBLIC <input checked="" type="checkbox"/> PRIVATE <input type="checkbox"/>
WELL (SPRING) APPEARS TO MEET CONSTRUCTION STANDARDS AT TIME OF INSPECTION () YES () NO Chubbuck City Water	EHS SIGNATURE <i>[Signature]</i>		EHS # 64
REMARKS			

APPROVED PLANS

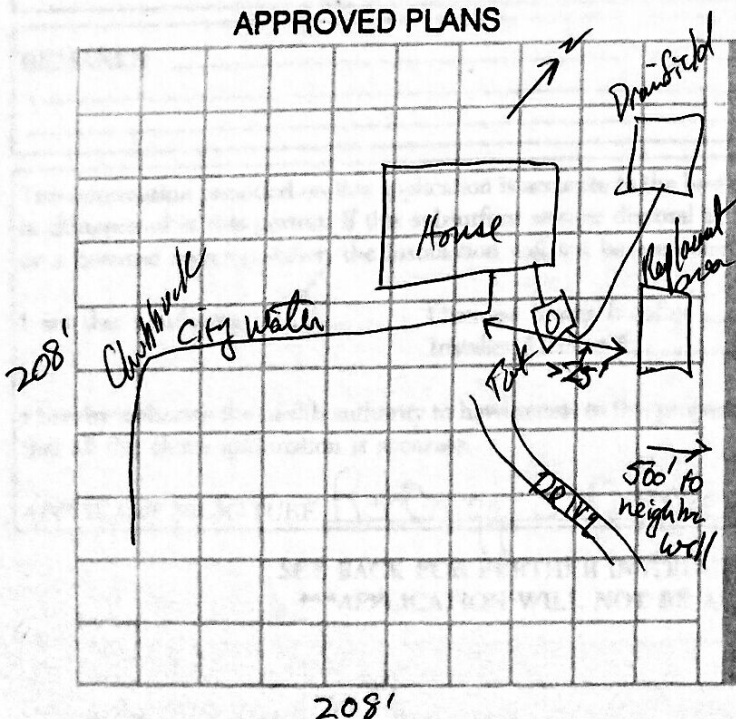

AS BUILT PLANS

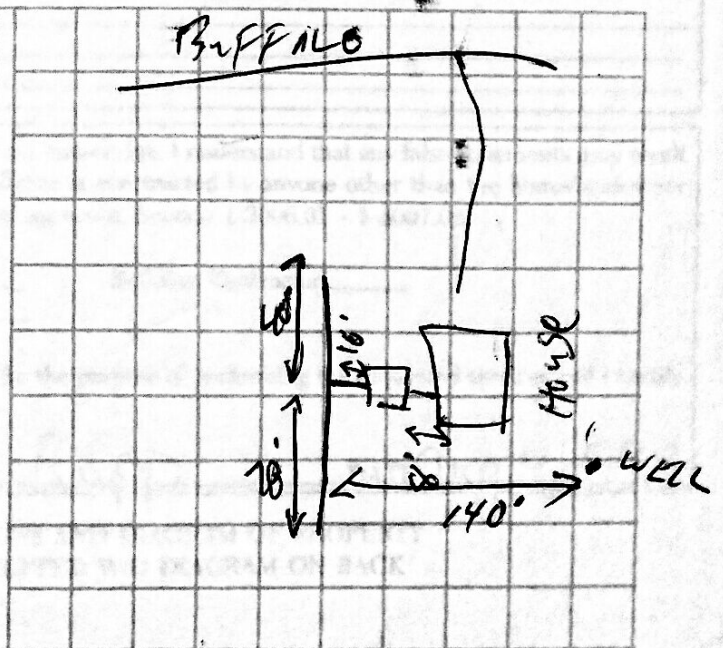

208'