

JURISDICTION  
 300  
 TRAVEL TIME: 60  
 INSPECTION TIME: 45

SOUTHEASTERN DISTRICT HEALTH DEPARTMENT  
 465 MEMORIAL DRIVE  
 POCATELLO, ID

LOW LM  
 FEE PD  Y  N  
 PERMIT # 47407

**\*\*APPLICATION AND PERMIT VALID FOR ONE YEAR FROM DATE OF ISSUANCE**

NAME Vickie Hansen		PHONE 238-7090	PROPERTY ADDRESS Rio Vista Rd		
MAILING ADDRESS:		LEGAL DESCRIPTION: LOT SIZE (ACRES) 2.5			
STREET/P.O. BOX		¼ SECTION 52 SECTION 6		TOWNSHIP 6	RANGE 34
CITY		LOT #		BLOCK #	SUBDIVISION
STATE		ZIP		PARCEL # R385 300 829 FROM TAX ASSESSOR'S OFFICE	
SEPTIC TANK SIZE 1000 gal.	EST TYPE 232	EFFECTIVE DISPOSAL AREA 556 SQ.FT.	SOIL TYPE B2	MAXIMUM DEPTH BELOW GROUND SURFACE 3'	# BEDROOMS 3

INSTALLATION MUST BE BY LICENSED SEWER INSTALLER OR HOME/LANDOWNER

EHS SIGNATURE Steve J. Row	EHS # 64	APPLICANT SIGNATURE James R Estel	DATE 12-1-93
-------------------------------	-------------	--------------------------------------	-----------------

REMARKS

**INSPECTION**

THE DISTRICT HEALTH DEPARTMENT SHALL BE NOTIFIED OF INSTALLATION 48 HOURS PRIOR TO INSTALLATION

SEPTIC TANK SIZE 1000 gal	STANDPIPE: ( ) YES (X) NO	MANHOLE DEPTH 12'	DEPTH BELOW GROUND SURFACE 3'	ROCK UNDER PIPE N/A
EFFECTIVE DISPOSAL AREA 556 sq. ft.	INSTALLATION APPROVED <input checked="" type="checkbox"/> DISAPPROVED	INSTALLER JVS	INSTALLER # 903	

EHS SIGNATURE Steve J. Row	DATE 12-22-93	EHS # 64
-------------------------------	------------------	-------------


REMARKS Infiltrator system = 560 equivalent ft<sup>2</sup>

**WATER SYSTEM**

PLANS APPROVED YES <input checked="" type="checkbox"/> NO	SAMPLE COLLECTED BY	DATE	STATE LAB INDICATES INTESTINAL BACTERIA WERE _____ WERE NOT _____ FOUND
MIN. DISTANCES PER STANDARDS/REGS. YES <input checked="" type="checkbox"/> NO	CHEMICAL PARAMETERS TESTED _____ WITHIN LIMITS YES _____ NO		SYSTEM PUBLIC _____ PRIVATE <input checked="" type="checkbox"/>
WELL (SPRING) APPEARS TO MEET CONSTRUCTION STANDARDS AT TIME OF INSPECTION (X) YES ( ) NO	EHS SIGNATURE Steve J. Row		EHS # 64

REMARKS

**APPROVED PLANS**

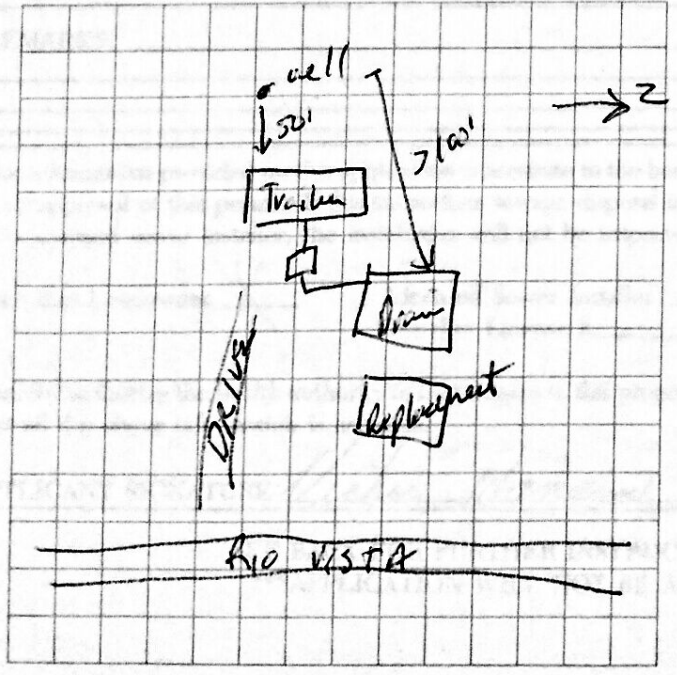

**AS BUILT PLANS**

