

JURISDICTION
300

SOUTHEASTERN DISTRICT HEALTH DEPARTMENT
465 MEMORIAL DRIVE
POCATELLO, ID

FEE PD Y N
PERMIT # 85162

TRAVEL TIME: 30
INSPECTION TIME: 45

200-315

**APPLICATION AND PERMIT VALID FOR ONE YEAR FROM DATE OF ISSUANCE

NAME MARK LOWE		PHONE 232-2065	PROPERTY ADDRESS 13596 W. MEADOW HARK LN		
MAILING ADDRESS 13596 W. MEADOW HARK LN		LEGAL DESCRIPTION: 1/4 SECTION NW SECTION 33 TOWNSHIP 6S RANGE 34E		LOT SIZE (ACRES)	
STREET/P.O. BOX		LOT #		BLOCK #	
CITY POCATELLO		SUBDIVISION		PARCEL # R3853030200	
STATE ID		ZIP 83204		FROM TAX ASSESSOR'S OFFICE	
SEPTIC TANK SIZE EXISTING gal.	EST TYPE 237	EFFECTIVE DISPOSAL AREA 328 SQ.FT.	SOIL TYPE B-2	MAXIMUM DEPTH BELOW GROUND SURFACE 4'	# BEDROOMS 5

INSTALLATION MUST BE BY LICENSED SEWER INSTALLER OR HOME/LANDOWNER

EHS SIGNATURE <i>Steve J. Ro</i>	EHS # 64	APPLICANT SIGNATURE Mark Lowe	DATE 6-27-94
REMARKS Addition to existing system - 66 ft of well/trator = 330 sq ft			

INSPECTION

THE DISTRICT HEALTH DEPARTMENT SHALL BE NOTIFIED OF INSTALLATION 48 HOURS PRIOR TO INSTALLATION

SEPTIC TANK SIZE 1000 gal	STANDPIPE: () YES (X) NO	MANHOLE DEPTH 3 FT	DEPTH BELOW GROUND SURFACE 4 FT	ROCK UNDER PIPE infiltration
EFFECTIVE DISPOSAL AREA 330 sq ft	INSTALLATION APPROVED <input checked="" type="checkbox"/>	DISAPPROVED	INSTALLER J&J construction	INSTALLER # 903

EHS SIGNATURE <i>Steve J. Ro</i>	DATE 05/15/75	EHS # 69
REMARKS no standpipe		


WATER SYSTEM

PLANS APPROVED YES <input checked="" type="checkbox"/> NO	SAMPLE COLLECTED BY	DATE	STATE LAB INDICATES INTESTINAL BACTERIA WERE _____ WERE NOT _____ FOUND
MIN. DISTANCES PER STANDARDS/REGS. YES _____ NO	CHEMICAL PARAMETERS TESTED WITHIN LIMITS YES _____ NO	SYSTEM PUBLIC _____ PRIVATE <input checked="" type="checkbox"/>	

WELL (SPRING) APPEARS TO MEET CONSTRUCTION STANDARDS AT TIME OF INSPECTION (X) YES () NO	EHS SIGNATURE	EHS #
--	---------------	-------

REMARKS Infiltrators

APPROVED PLANS

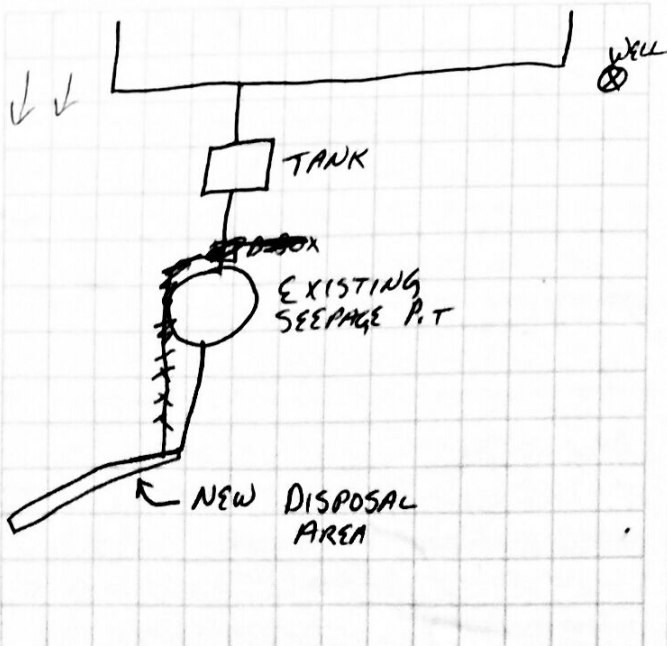

AS BUILT PLANS

