

JURISDICTION  
**300**  
TRAVEL TIME: \_\_\_\_\_  
INSPECTION TIME: \_\_\_\_\_

SOUTHEASTERN DISTRICT HEALTH DEPARTMENT  
465 MEMORIAL DRIVE  
POCATELLO, ID  
233-9080

GW

FEE PD  Y  N  
PERMIT # 94434

**\*\*APPLICATION AND PERMIT VALID FOR ONE YEAR FROM DATE OF ISSUANCE**

NAME <i>Horton, Dave</i>	PHONE <i>237-9371</i>	PROPERTY ADDRESS <i>Philton Rd.</i>
MAILING ADDRESS: <i>4880 Georgetown</i>	LEGAL DESCRIPTION: LOT SIZE (ACRES) <i>1.5</i>	
STREET/P.O. BOX <i>4880 Georgetown</i>	1/4 SECTION <i>NE</i> SECTION <i>8</i> TOWNSHIP <i>6</i> RANGE <i>34</i>	
CITY <i>Chubbuck</i>	LOT # _____ BLOCK # _____ SUBDIVISION _____	
STATE <i>ID</i>	ZIP <i>83202</i>	PARCEL # <i>R385 301 4407</i> FROM TAX ASSESSOR'S OFFICE
SEPTIC TANK SIZE <i>1000 gal.</i>	EST TYPE <i>232</i>	EFFECTIVE DISPOSAL AREA <i>667 SQ.FT.</i>
		SOIL TYPE <i>B2</i>
		MAXIMUM DEPTH BELOW GROUND SURFACE <i>4 feet</i>
		# BEDROOMS <i>4</i>

**INSTALLATION MUST BE BY LICENSED SEWER INSTALLER OR HOME/LANDOWNER**

EHS SIGNATURE <i>Steve S. [Signature]</i>	EHS # <i>64</i>	APPLICANT SIGNATURE <i>[Signature]</i>	DATE <i>5-11-94</i>
--	--------------------	---	------------------------

REMARKS *If go to 5 bedrooms need 1250 gal tank and 778 ft<sup>2</sup> of drain bed - call if any changes*

**THE DISTRICT HEALTH DEPARTMENT SHALL BE NOTIFIED OF INSTALLATION 48 HOURS PRIOR TO INSTALLATION**

SEPTIC TANK SIZE _____ gal	STANDPIPE: ( ) YES ( ) NO	MANHOLE DEPTH	DEPTH BELOW GROUND SURFACE	ROCK UNDER PIPE
EFFECTIVE DISPOSAL AREA _____ sq. ft.	INSTALLATION APPROVED _____ DISAPPROVED _____	INSTALLER		INSTALLER #

EHS SIGNATURE	DATE	EHS #
---------------	------	-------

REMARKS


**WATER SYSTEM**

PLANS APPROVED YES <input checked="" type="checkbox"/> NO _____	SAMPLE COLLECTED BY	DATE	STATE LAB INDICATES INTESTINAL BACTERIA WERE _____ WERE NOT _____ FOUND
MIN. DISTANCES PER STANDARDS/REGS. YES _____ NO _____	CHEMICAL PARAMETERS TESTED WITHIN LIMITS YES _____ NO _____	SYSTEM PUBLIC _____ PRIVATE <input checked="" type="checkbox"/>	

WELL (SPRING) APPEARS TO MEET CONSTRUCTION STANDARDS AT TIME OF INSPECTION ( ) YES ( ) NO	EHS SIGNATURE	EHS #
--	---------------	-------

REMARKS

**APPROVED PLANS**

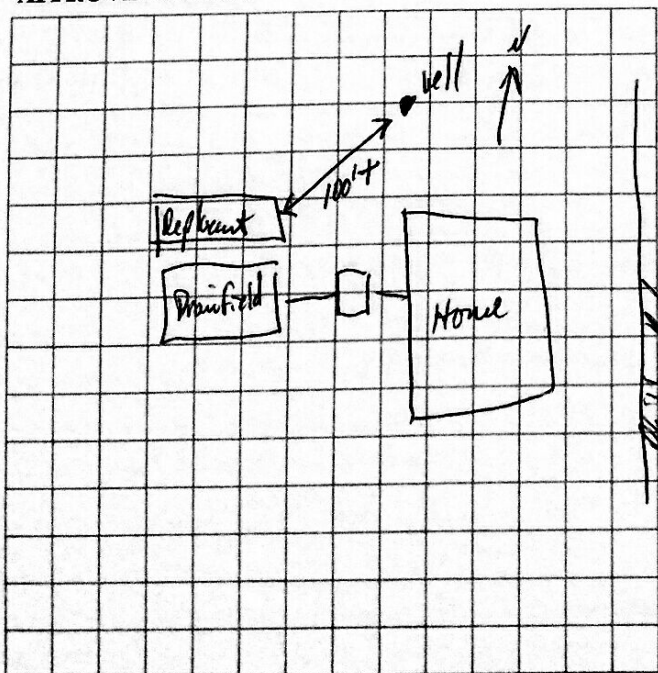

**AS BUILT PLANS**

