

JURISDICTION

300

SOUTHEASTERN DISTRICT HEALTH DEPARTMENT  
465 MEMORIAL DRIVE  
POCATELLO, ID

FEE PD  Y  N  
PERMIT # 86380

TRAVEL TIME: 30  
INSPECTION TIME: 30

\*\*APPLICATION AND PERMIT VALID FOR ONE YEAR FROM DATE OF ISSUANCE

NAME C. Bud Hanson		PHONE 237-1239	PROPERTY ADDRESS Philbin Rd	
MAILING ADDRESS:		LEGAL DESCRIPTION: LOT SIZE (ACRES) 13		
STREET/P.O. BOX Oxbow Motel		1/4 SECTION SW SECTION 4 TOWNSHIP 65 RANGE 34EPM		
CITY Chubbuck		LOT # _____ BLOCK # _____ SUBDIVISION _____		
STATE _____ ZIP _____		PARCEL # R3853005700 FROM TAX ASSESSOR'S OFFICE		
SEPTIC TANK SIZE 1000 gal.	EST TYPE 232	EFFECTIVE DISPOSAL AREA 833 sq. ft.	SOIL TYPE C1	MAXIMUM DEPTH BELOW GROUND SURFACE 4 feet
				# BEDROOMS 2

INSTALLATION MUST BE BY LICENSED SEWER INSTALLER OR HOME/LANDOWNER

EHS SIGNATURE <i>[Signature]</i>	EHS # 64	APPLICANT SIGNATURE C. Bud Hanson	DATE 8-2-94
REMARKS Changed to 2 bed 8-8-94 OR 1066742 SPW			

INSPECTION

THE DISTRICT HEALTH DEPARTMENT SHALL BE NOTIFIED OF INSTALLATION 48 HOURS PRIOR TO INSTALLATION

SEPTIC TANK SIZE 1000 gal	STANDPIPE: ( ) YES (X) NO	MANHOLE DEPTH 16"	DEPTH BELOW GROUND SURFACE 2'	ROCK UNDER PIPE N/A Intake for system
EFFECTIVE DISPOSAL AREA 454 sq. ft.	INSTALLATION APPROVED (X) DISAPPROVED _____	INSTALLER Miller Excavator Brent Miller 920		

EHS SIGNATURE Richard Larsen	DATE 10/7/94	EHS # 62
---------------------------------	-----------------	-------------

REMARKS

WATER SYSTEM


PLANS APPROVED YES <input checked="" type="checkbox"/> NO _____	SAMPLE COLLECTED BY _____	DATE _____	STATE LAB INDICATES INTESTINAL BACTERIA WERE _____ WERE NOT _____ FOUND
MIN. DISTANCES PER STANDARDS/REGS. YES _____ NO _____	CHEMICAL PARAMETERS TESTED WITHIN LIMITS YES _____ NO _____	SYSTEM PUBLIC _____ PRIVATE <input checked="" type="checkbox"/>	

WELL (SPRING) APPEARS TO MEET CONSTRUCTION STANDARDS AT TIME OF INSPECTION ( ) YES ( ) NO	EHS SIGNATURE _____	EHS # _____
--	---------------------	-------------

REMARKS well not installed at time of inspection

APPROVED PLANS

Philbin

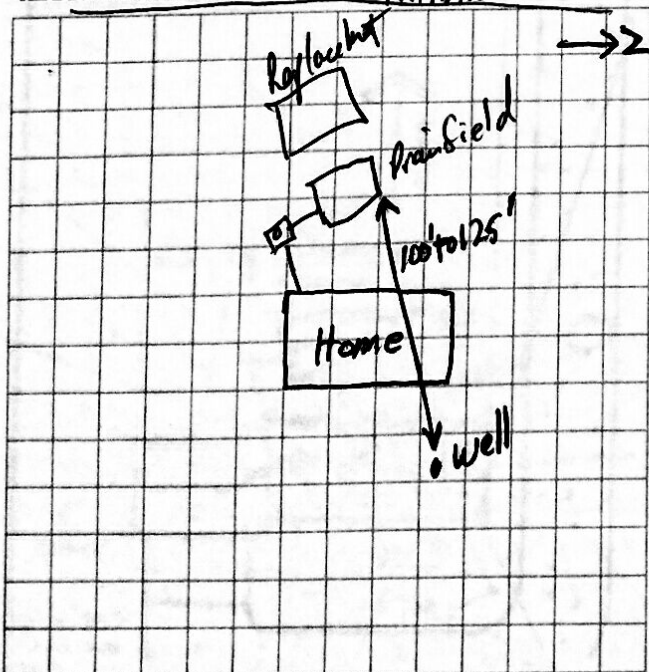

AS BUILT PLANS

