

JURISDICTION  
0390  
TRAVEL TIME: 30  
INSPECTION TIME: 30

SOUTHEASTERN DISTRICT HEALTH DEPARTMENT  
465 MEMORIAL DRIVE  
POCATELLO, ID

G.W.G.W  
FEE PD  Y  N  
PERMIT # 160645

**\*\*APPLICATION AND PERMIT VALID FOR ONE YEAR FROM DATE OF ISSUANCE**

NAME <i>Kathleen Eby</i>		PHONE <i>233-7875</i>	PROPERTY ADDRESS <i>Corner of Gathe Rd. / Millward</i>		
MAILING ADDRESS:		LEGAL DESCRIPTION: LOT SIZE (ACRES) <i>1.25</i>			
STREET/P.O. BOX <i>12907 W. Millward</i>		¼ SECTION <i>NW</i> SECTION <i>22</i> TOWNSHIP <i>6S</i> RANGE <i>34E</i>			
CITY <i>Pocatello</i>		LOT # _____ BLOCK # _____ SUBDIVISION _____			
STATE <i>Idaho</i>		PARCEL # <i>R 3859026402</i> FROM TAX ASSESSOR'S OFFICE			
SEPTIC TANK SIZE <i>1000 gal.</i>	EST TYPE <i>232</i>	EFFECTIVE DISPOSAL AREA <i>556 SQ.FT.</i>	SOIL TYPE <i>B-2</i>	MAXIMUM DEPTH BELOW GROUND SURFACE <i>4</i>	# BEDROOMS <i>3</i>

INSTALLATION MUST BE BY LICENSED SEWER INSTALLER OR HOME/LANDOWNER

EHS SIGNATURE <i>Craig Madson</i>	EHS # <i>65</i>	APPLICANT SIGNATURE <i>Kathleen Eby</i>	DATE <i>10/2/95</i>
REMARKS <i>Well is only 97ft to drain side, allotted under 10% variance of 01.83010 D.T.G.M.</i>			

THE DISTRICT HEALTH DEPARTMENT SHALL BE NOTIFIED OF INSTALLATION 48 HOURS PRIOR TO INSTALLATION


SEPTIC TANK SIZE <i>1000 gal.</i>	STANDPIPE: ( ) YES ( <input checked="" type="checkbox"/> ) NO	MANHOLE DEPTH <i>18 in</i>	DEPTH BELOW GROUND SURFACE <i>4ft</i>	ROCK UNDER PIPE <i>Int.</i>
EFFECTIVE DISPOSAL AREA <i>556 sq. ft.</i>	INSTALLATION APPROVED <input checked="" type="checkbox"/> DISAPPROVED _____	INSTALLER <i>Clyton Coker</i>		INSTALLER # <i>909</i>

EHS SIGNATURE <i>Gale</i>	DATE <i>11/14/95</i>	EHS # <i>69</i>
REMARKS		

WATER SYSTEM			
PLANS APPROVED YES <input checked="" type="checkbox"/> NO _____	SAMPLE COLLECTED BY	DATE	STATE LAB INDICATES INTESTINAL BACTERIA WERE _____ WERE NOT _____ FOUND
MIN. DISTANCES PER STANDARDS/REGS. YES <input checked="" type="checkbox"/> NO _____	CHEMICAL PARAMETERS TESTED WITHIN LIMITS YES _____ NO _____		SYSTEM PUBLIC _____ PRIVATE <input checked="" type="checkbox"/>
WELL (SPRING) APPEARS TO MEET CONSTRUCTION STANDARDS AT TIME OF INSPECTION <input checked="" type="checkbox"/> YES ( ) NO	EHS SIGNATURE		EHS #

REMARKS

APPROVED PLANS *Gathe Rd*

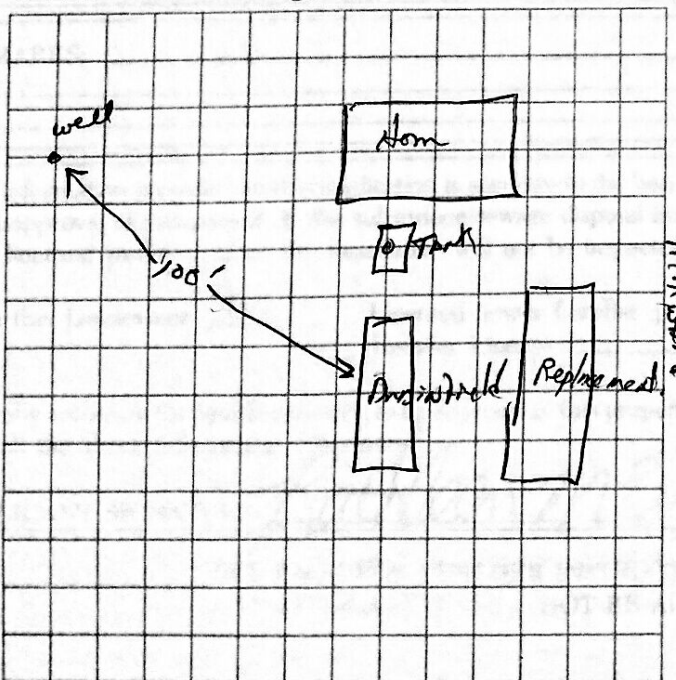

AS BUILT PLANS

