

JURISDICTION 390
 TRAVEL TIME: 30
 INSPECTION TIME: 30

SOUTHEASTERN DISTRICT HEALTH DEPARTMENT
 465 MEMORIAL DRIVE
 POCATELLO, ID

611 State
 FEE PD Y N
 PERMIT # 161799

****APPLICATION AND PERMIT VALID FOR ONE YEAR FROM DATE OF ISSUANCE**

NAME <u>National Guard</u>		PHONE <u>(208) 237-3700</u>	PROPERTY ADDRESS <u>10714 N Fairgrounds Rd</u>	
MAILING ADDRESS: <u>10714 North</u>		LEGAL DESCRIPTION: LOT SIZE (ACRES) _____		
STREET/P.O. BOX <u>Fairgrounds Rd</u>		1/4 SECTION <u>14</u>	SECTION <u>12</u>	TOWNSHIP <u>63</u> RANGE <u>34E</u>
CITY <u>Pocatello</u>		LOT # _____	BLOCK # _____	SUBDIVISION _____
STATE <u>Id</u>		PARCEL # <u>R3853016400</u>		FROM TAX ASSESSOR'S OFFICE
SEPTIC TANK SIZE <u>2000 gal.</u>	EST TYPE _____	EFFECTIVE DISPOSAL AREA <u>2900 SQ.FT.</u>	SOIL TYPE <u>B2</u>	MAXIMUM DEPTH BELOW GROUND SURFACE <u>4 FT</u>
# BEDROOMS _____				

INSTALLATION MUST BE BY LICENSED SEWER INSTALLER OR HOME/LANDOWNER

EHS SIGNATURE <u>[Signature]</u>	EHS # <u>69</u>	APPLICANT SIGNATURE <u>[Signature]</u>	DATE <u>4 Oct 95</u>
REMARKS <u>Must be Absorption bed</u>			

INSPECTION

THE DISTRICT HEALTH DEPARTMENT SHALL BE NOTIFIED OF INSTALLATION 48 HOURS PRIOR TO INSTALLATION

SEPTIC TANK SIZE _____ gal	STANDPIPE: () YES (X) NO	MANHOLE DEPTH _____	DEPTH BELOW GROUND SURFACE <u>4 FT</u>	ROCK UNDER PIPE <u>Bin</u>
EFFECTIVE DISPOSAL AREA <u>2900</u> sq. ft.	INSTALLATION APPROVED <u>X</u> DISAPPROVED _____	INSTALLER <u>Soc Crawford</u>	INSTALLER # _____	

EHS SIGNATURE <u>[Signature]</u>	DATE <u>1/13/95</u>	EHS # <u>69</u>
REMARKS _____		


WATER SYSTEM

PLANS APPROVED YES _____ NO _____	SAMPLE COLLECTED BY _____	DATE _____	STATE LAB INDICATES INTESTINAL BACTERIA WERE _____ WERE NOT _____ FOUND
MIN. DISTANCES PER STANDARDS/REGS. YES _____ NO _____	CHEMICAL PARAMETERS TESTED WITHIN LIMITS YES _____ NO _____	SYSTEM PUBLIC _____ PRIVATE _____	

WELL (SPRING) APPEARS TO MEET CONSTRUCTION STANDARDS AT TIME OF INSPECTION () YES () NO	EHS SIGNATURE _____	EHS # _____
---	---------------------	-------------

REMARKS _____

APPROVED PLANS

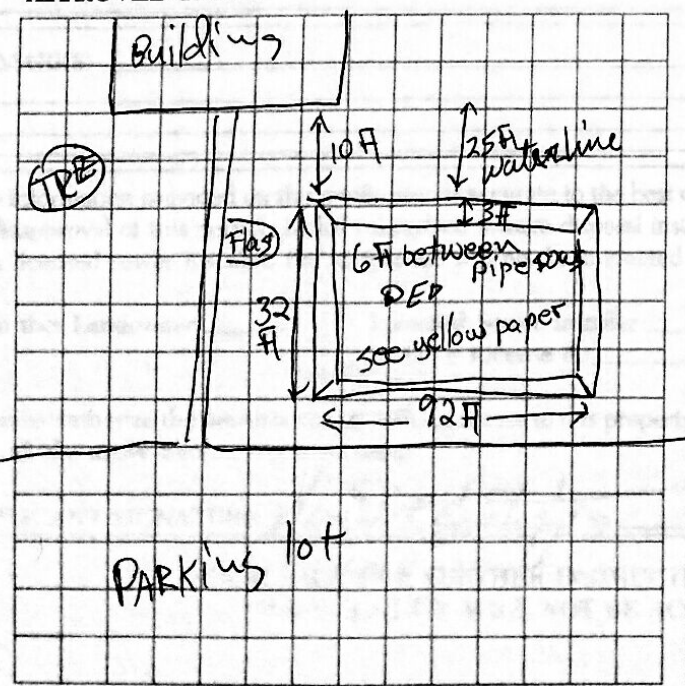

AS BUILT PLANS

