

JURISDICTION 300
 TRAVEL TIME: 30
 INSPECTION TIME: 30

SOUTHEASTERN DISTRICT HEALTH DEPARTMENT
 465 MEMORIAL DRIVE
 POCATELLO, ID

G.W.G.W

FEE PD Y N
 PERMIT # 106198

****APPLICATION AND PERMIT VALID FOR ONE YEAR FROM DATE OF ISSUANCE**

NAME <u>Lewis Mechanical & Mtl Works</u>		PHONE <u>237-1314</u>	PROPERTY ADDRESS <u>15134 Hanziker Rd.</u>		
MAILING ADDRESS:		LEGAL DESCRIPTION: LOT SIZE (ACRES) <u>2.6</u>			
STREET/PO. BOX <u>15134 Hanziker Rd</u>		1/4 SECTION <u>NE, SE</u> SECTION <u>6</u> TOWNSHIP <u>6</u> RANGE <u>34e</u>			
CITY <u>Poc</u>		LOT # _____ BLOCK # _____ SUBDIVISION _____			
STATE <u>Id</u>		ZIP <u>83202</u>		PARCEL # <u>R3853009214</u> ²¹⁵ / ₂₁₆ FROM TAX ASSESSOR'S OFFICE	
SEPTIC TANK SIZE <u>1000</u> gal.	EST TYPE <u>235</u>	EFFECTIVE DISPOSAL AREA <u>700</u> SQ.FT.	SOIL TYPE <u>B-2</u>	MAXIMUM DEPTH BELOW GROUND SURFACE <u>4"</u>	# BEDROOMS <u>Business</u>
24 Sec. Sewers. INSTALLATION MUST BE BY LICENSED SEWER INSTALLER OR HOME/LANDOWNER					<u>2035 employe</u>
EHS SIGNATURE <u>Craig Madison</u>		EHS # <u>65</u>	APPLICANT SIGNATURE <u>Dan DeLo</u>		DATE <u>19 Mar 96</u>
REMARKS <u>f</u>					

INSPECTION

THE DISTRICT HEALTH DEPARTMENT SHALL BE NOTIFIED OF INSTALLATION 48 HOURS PRIOR TO INSTALLATION

SEPTIC TANK SIZE <u>1000</u> gal <u>pre-cast</u>	STANDPIPE: (<input checked="" type="checkbox"/>) YES () NO	MANHOLE DEPTH <u>at surface</u>	DEPTH BELOW GROUND SURFACE <u>3ft</u>	ROCK UNDER PIPE <u>Intil</u>
EFFECTIVE DISPOSAL AREA <u>350</u> sq. ft.	INSTALLATION APPROVED <input checked="" type="checkbox"/> DISAPPROVED _____	INSTALLER <u>Self</u>		


EHS SIGNATURE <u>[Signature]</u>	DATE <u>080896</u>	EHS # <u>69</u>
REMARKS <u>code = 6</u>		

WATER SYSTEM

PLANS APPROVED YES <input checked="" type="checkbox"/> NO _____	SAMPLE COLLECTED BY _____	DATE _____	STATE LAB INDICATES INTESTINAL BACTERIA WERE _____ WERE NOT _____ FOUND
MIN. DISTANCES PER STANDARDS/REGS. YES <input checked="" type="checkbox"/> NO _____	CHEMICAL PARAMETERS TESTED _____	SYSTEM PUBLIC _____ PRIVATE <input checked="" type="checkbox"/>	

WELL (SPRING) APPEARS TO MEET CONSTRUCTION STANDARDS AT TIME OF INSPECTION (<input checked="" type="checkbox"/>) YES () NO	EHS SIGNATURE <u>[Signature]</u>	EHS # <u>69</u>
REMARKS		

APPROVED PLANS

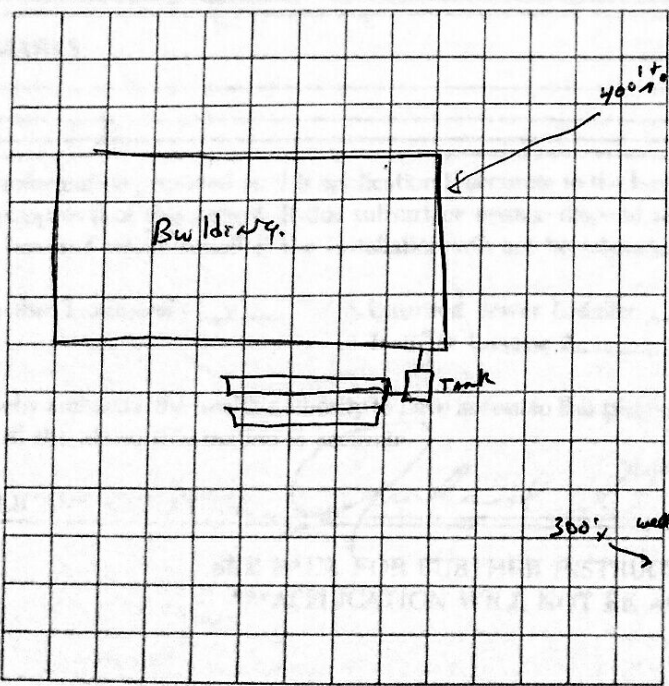

AS BUILT PLANS

