

775-3830

GW

4485

JURISDICTION 300

SOUTHEASTERN DISTRICT HEALTH DEPARTMENT
465 MEMORIAL DRIVE
POCATELLO, ID

FEE PD Y N
PERMIT 17875

TRAVEL TIME: 30 ✓ / 30 ✓
INSPECTION TIME: 30 ✓ / 160 ✓

Code G

**APPLICATION AND PERMIT VALID FOR ONE YEAR FROM DATE OF ISSUANCE

NAME Glen Oakes		PHONE 235-1200	PROPERTY ADDRESS Pacer Rd		
MAILING ADDRESS:		LEGAL DESCRIPTION: LOT SIZE (ACRES) 4.8			
STREET/P.O. BOX 106 Mountain Rd		1/4 SECTION Center 1/2 SECTION 21 TOWNSHIP 6 RANGE 34			
CITY Pocatello		LOT # _____ BLOCK # _____ SUBDIVISION _____			
STATE Id		ZIP 83204		PARCEL # 38530622901 FROM TAX ASSESSOR'S OFFICE	
SEPTIC TANK SIZE 1000 gal.	EST TYPE 232	EFFECTIVE DISPOSAL AREA 833 SQ.FT.	SOIL TYPE C1	MAXIMUM DEPTH BELOW GROUND SURFACE 4	# BEDROOMS 3

INSTALLATION MUST BE BY LICENSED SEWER INSTALLER OR HOME/LANDOWNER

EHS SIGNATURE Craig Madison	EHS # 65	APPLICANT SIGNATURE Kenny Campbell	DATE 1-28-97
--------------------------------	-------------	---------------------------------------	-----------------

REMARKS

INSPECTION

THE DISTRICT HEALTH DEPARTMENT SHALL BE NOTIFIED OF INSTALLATION 48 HOURS PRIOR TO INSTALLATION

SEPTIC TANK SIZE 1000 gal cast	STANDPIPE: () YES (X) NO	MANHOLE DEPTH 18 1/4	DEPTH BELOW GROUND SURFACE 4 1/2	ROCK UNDER PIPE Int'l / 27
EFFECTIVE DISPOSAL AREA 7100 sq. ft.	INSTALLATION APPROVED <input checked="" type="checkbox"/> DISAPPROVED <input checked="" type="checkbox"/>	INSTALLER Kenny Campbell / SELF		INSTALLER # AA#

EHS SIGNATURE John	DATE 04/03/97	EHS # 69
-----------------------	------------------	-------------

REMARKS This drain field is looking 2 units, Kenny Campbell is not a licensed installer & is not where to be found. Even though Mr. Campbell never got license or installed the tank apparently the user OK.

WATER SYSTEM


PLANS APPROVED YES <input checked="" type="checkbox"/> NO _____	SAMPLE COLLECTED BY	DATE	STATE LAB INDICATES INTESTINAL BACTERIA WERE _____ WERE NOT _____ FOUND
--	---------------------	------	---

MIN. DISTANCES PER STANDARDS/REGS. YES <input checked="" type="checkbox"/> NO _____	CHEMICAL PARAMETERS TESTED WITHIN LIMITS YES _____ NO _____	SYSTEM PUBLIC _____ PRIVATE <input checked="" type="checkbox"/>
--	--	--


WELL (SPRING) APPEARS TO MEET CONSTRUCTION STANDARDS AT TIME OF INSPECTION (X) YES () NO	EHS SIGNATURE John	EHS # 69
--	-----------------------	-------------

REMARKS

APPROVED PLANS

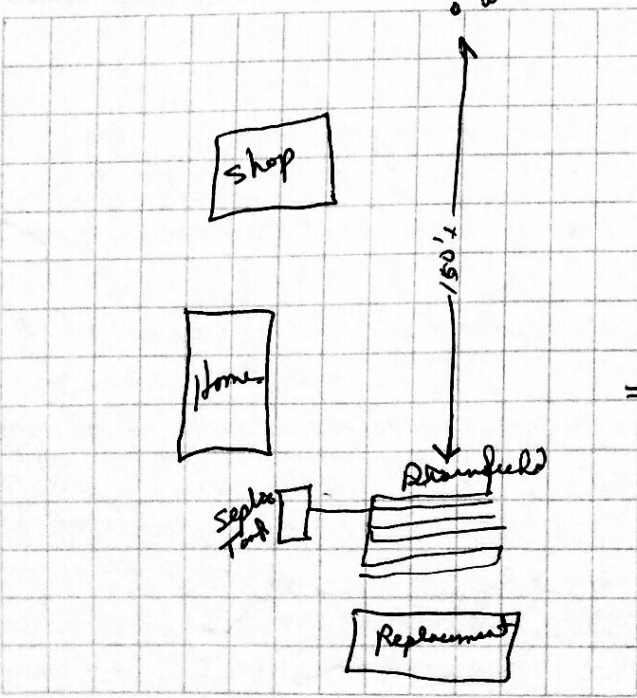

AS BUILT PLANS

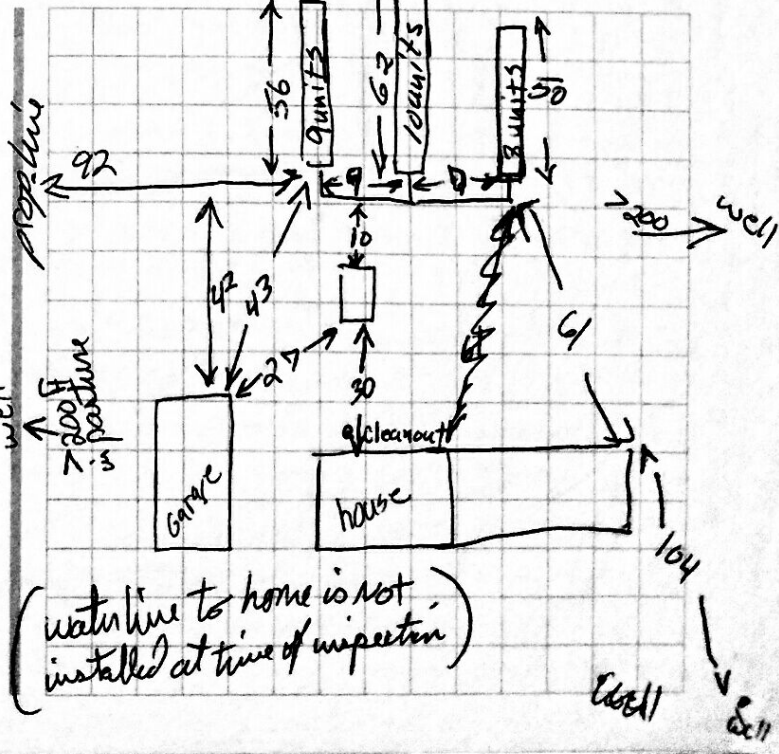

Pacer Rd

well