

JURISDICTION 0300 #69

04/21/83 05/03/83

SOUTHEASTERN DISTRICT HEALTH DEPARTMENT
69465 MEMORIAL DRIVE
POCATELLO, ID

GWJGW #44309

FEE PD Y N
PERMIT # 122029

TRAVEL TIME: 30 / 30
INSPECTION TIME: 60 / 45

Code C

**APPLICATION AND PERMIT VALID FOR ONE YEAR FROM DATE OF ISSUANCE

NAME LDS Church		PHONE 237-8916	PROPERTY ADDRESS 13979 W Siphon Road		
MAILING ADDRESS:		LEGAL DESCRIPTION: LOT SIZE (ACRES) 3.5			
STREET#& BOX 13979 W Siphon Rd		1/4 SECTION	SECTION 4	TOWNSHIP 6s	RANGE 34e
CITY Pocatello		LOT #	BLOCK #	SUBDIVISION	
STATE Id		ZIP		PARCEL # R3853005100 FROM TAX ASSESSOR'S OFFICE	
SEPTIC TANK SIZE 2000 gal.	EST TYPE 236	EFFECTIVE DISPOSAL AREA 990 SQ.FT.	SOIL TYPE B2	MAXIMUM DEPTH BELOW GROUND SURFACE 4'	# BEDROOMS -

INSTALLATION MUST BE BY LICENSED SEWER INSTALLER OR HOME/LANDOWNER

EHS SIGNATURE Craig Madison	EHS # 65	APPLICANT SIGNATURE H.W. JENSEN	DATE 7-29-97
REMARKS			

INSPECTION
THE DISTRICT HEALTH DEPARTMENT SHALL BE NOTIFIED OF INSTALLATION 48 HOURS PRIOR TO BACKFILLING

SEPTIC TANK SIZE (2000) gal	STANDPIPE: (X) YES () NO	MANHOLE DEPTH at ground level	DEPTH BELOW GROUND SURFACE 3ft	ROCK UNDER PIPE 7in
EFFECTIVE DISPOSAL AREA 990 sq. ft.	INSTALLATION APPROVED (X) DISAPPROVED	INSTALLER CMS Mechanics	INSTALLER # 20074	


EHS SIGNATURE H.W. Jensen	DATE 05/08/83	EHS # 69
REMARKS		

WATER SYSTEM


PLANS APPROVED YES (X) NO	SAMPLE COLLECTED BY	DATE	STATE LAB INDICATES INTESTINAL BACTERIA WERE _____ WERE NOT _____ FOUND
MIN. DISTANCES PER STANDARDS/REGS. YES (X) NO	CHEMICAL PARAMETERS TESTED WITHIN LIMITS YES _____ NO _____	SYSTEM PUBLIC (X) PRIVATE	
WELL (SPRING) APPEARS TO MEET CONSTRUCTION STANDARDS AT TIME OF INSPECTION () YES (X) NO	EHS SIGNATURE H.W. Jensen		EHS # 69

REMARKS The well is 12" of ground surrounded by concrete base. 1/2 solid cap. 8" casing.

APPROVED PLANS

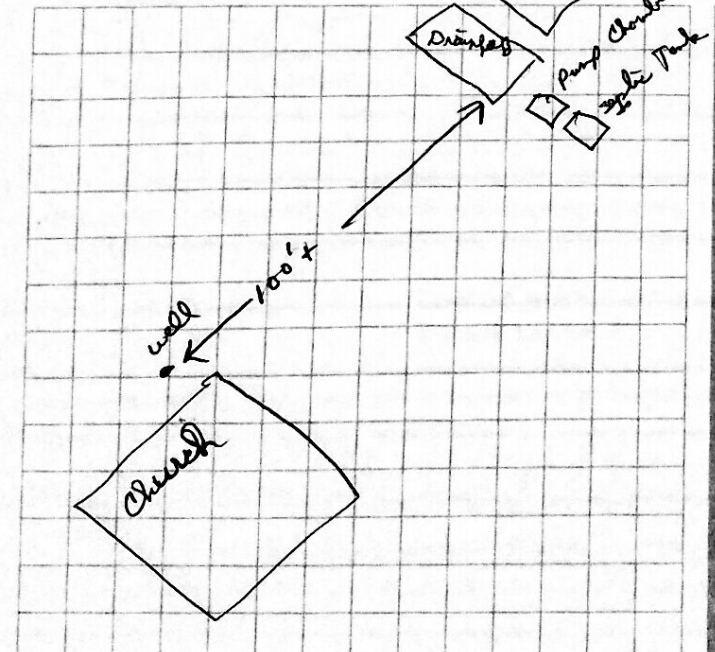

AS BUILT PLANS

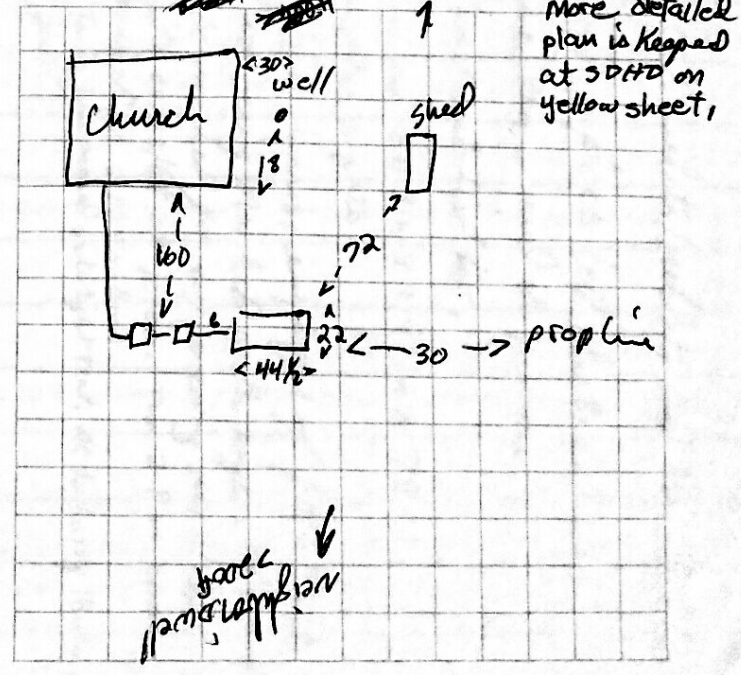

Siphon Rd

N ← Philbar Rd