

JURISDICTION
300

09/23/98
69

SOUTHEASTERN DISTRICT HEALTH DEPARTMENT
465 MEMORIAL DRIVE
POCATELLO, ID

FEE PD Y N
PERMIT # 128002

TRAVEL TIME: 15
INSPECTION TIME: 45

Code G

GW, GW

**APPLICATION AND PERMIT VALID FOR ONE YEAR FROM DATE OF ISSUANCE

NAME Idaho Power Co		PHONE 388-2781	PROPERTY ADDRESS Clubhook Rd		
MAILING ADDRESS: Po Box 70		LEGAL DESCRIPTION: LOT SIZE (ACRES) 2.5			
STREET/P.O. BOX		1/4 SECTION 11	SECTION 11	TOWNSHIP 6	RANGE 34
CITY Boise		LOT # 1	BLOCK # 1	SUBDIVISION Bayview/Saled	
STATE ID		PARCEL # RCP0037317		FROM TAX ASSESSOR'S OFFICE	
SEPTIC TANK SIZE 900 gal.	EST TYPE 234	EFFECTIVE DISPOSAL AREA 150 SQ.FT.	SOIL TYPE B2	MAXIMUM DEPTH BELOW GROUND SURFACE 4'	# BEDROOMS 2

INSTALLATION MUST BE BY LICENSED SEWER INSTALLER OR HOME LANDOWNER

EHS SIGNATURE <i>[Signature]</i>	EHS # 69	APPLICANT SIGNATURE <i>[Signature]</i>	DATE 5/27/98
REMARKS NEED COPY OF DEED PRIOR TO INSPECTION			

INSPECTION

THE DISTRICT HEALTH DEPARTMENT SHALL BE NOTIFIED OF INSTALLATION 48 HOURS PRIOR TO INSTALLATION

SEPTIC TANK SIZE 1000 gal	STANDPIPE: () YES (X) NO	MANHOLE DEPTH 18 in	DEPTH BELOW GROUND SURFACE 4 FT	ROCK UNDER PIPE 9 Infiltrators
EFFECTIVE DISPOSAL AREA 252 sq. ft.	INSTALLATION APPROVED X	DISAPPROVED	INSTALLER Hudd Exc.	INSTALLER # 14565


EHS SIGNATURE <i>[Signature]</i>	DATE 09/03/98	EHS # 69
REMARKS Measurements from foundation are to Tank's inlet baffel.		

WATER SYSTEM

PLANS APPROVED YES X NO	SAMPLE COLLECTED BY	DATE	STATE LAB INDICATES INTESTINAL BACTERIA WERE WERE NOT FOUND
MIN. DISTANCES PER STANDARDS/REGS. YES X NO	CHEMICAL PARAMETERS TESTED WITHIN LIMITS YES NO	SYSTEM PUBLIC X PRIVATE	
WELL (SPRING) APPEARS TO MEET CONSTRUCTION STANDARDS AT TIME OF INSPECTION () YES () NO	EHS SIGNATURE		EHS #

REMARKS City of Clubhook #2

APPROVED PLANS

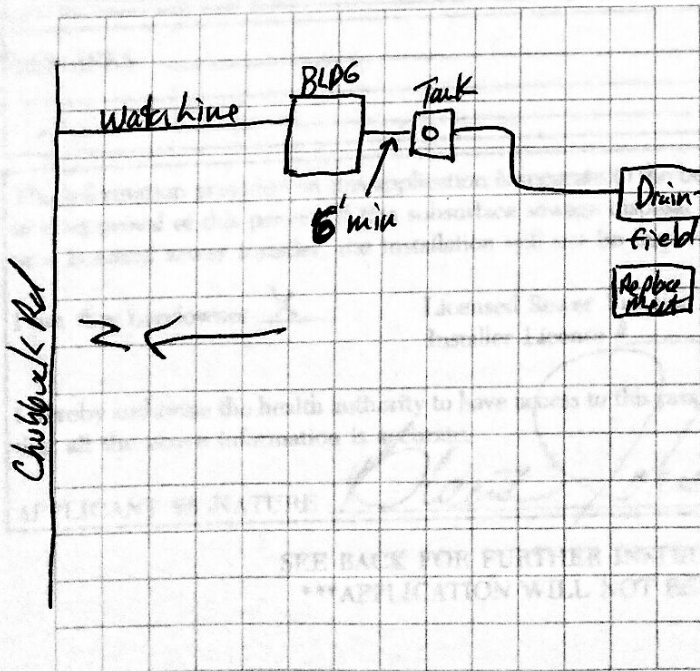

AS BUILT PLANS

