

JURISDICTION
3900

#65 *GW low*
SOUTHEASTERN DISTRICT HEALTH DEPARTMENT
1901 ALVIN RICKEN DRIVE POCATELLO, ID 83201

FEED Y N
PERMIT # 169523

TRAVEL TIME: 60 / /
INSPECTION TIME: 60 / /

**APPLICATION AND PERMIT VALID FOR ONE YEAR FROM DATE OF ISSUANCE

NAME FMC Idaho Inc		PHONE 236-8283	PROPERTY ADDRESS 612 Hwy 36 Pocatello		
MAILING ADDRESS		LEGAL DESCRIPTION: LOT SIZE (ACRES)			
STREET/P.O. BOX 4111		1/4 SECTION 45 lot 8 SECTION 7 TOWNSHIP 65 RANGE 37e			
CITY Pocatello		LOT # _____ BLOCK # _____ SUBDIVISION _____			
STATE Id		ZIP 83205-41	PARCEL # RPD 0406-06 FROM TAX ASSESSOR'S OFFICE		
SEPTIC TANK SIZE 1000 gal.	EST TYPE 235	EFFECTIVE DISPOSAL AREA 660 sq. ft.	SOIL TYPE B-2	MAXIMUM DEPTH BELOW GROUND SURFACE 4	# BEDROOMS NA

INSTALLATION MUST BE BY LICENSED SEWER INSTALLER OR HOME/LANDOWNER

DATE 5/10/06	EHS SIGNATURE Craig Madison	EHS# 65	APPLICANT SIGNATURE John Elle for FMC
REMARKS			

INSPECTION

THE DISTRICT HEALTH DEPARTMENT SHALL BE NOTIFIED OF INSTALLATION 48 HOURS PRIOR TO BACKFILLING

SEPTIC TANK SIZE 1000 gal.	STANDPIPE: () YES (X) NO	MANHOLE DEPTH 18"	DEPTH BELOW GROUND SURFACE 4'	ROCK UNDER PIPE 24' INfiltrators
EFFECTIVE DISPOSAL AREA 444 sq. ft.	INSTALLATION APPROVED <input checked="" type="checkbox"/> DISAPPROVED _____	INSTALLER Lupe Moreno		

EHS SIGNATURE Craig Madison	DATE 6/13/06	CODE G	EHS# 65
REMARKS manhole location: 10' north of element.			



WATER SYSTEM

PLANS APPROVED YES <input checked="" type="checkbox"/> NO _____	SAMPLE COLLECTED BY	DATE	STATE LAB INDICATES INTESTINAL BACTERIA WERE _____ WERE NOT _____ FOUND
MIN. DISTANCES PER STANDARDS/REGS. YES <input checked="" type="checkbox"/> NO _____	CHEMICAL PARAMETERS TESTED WITHIN LIMITS YES _____ NO _____	SYSTEM PUBLIC _____ PRIVATE <input checked="" type="checkbox"/>	

WELL (SPRING) APPEARS TO MEET CONSTRUCTION STANDARDS AT TIME OF INSPECTION () YES () NO <i>NA</i>	EHS SIGNATURE	EHS#
--	---------------	------

REMARKS

APPROVED PLANS

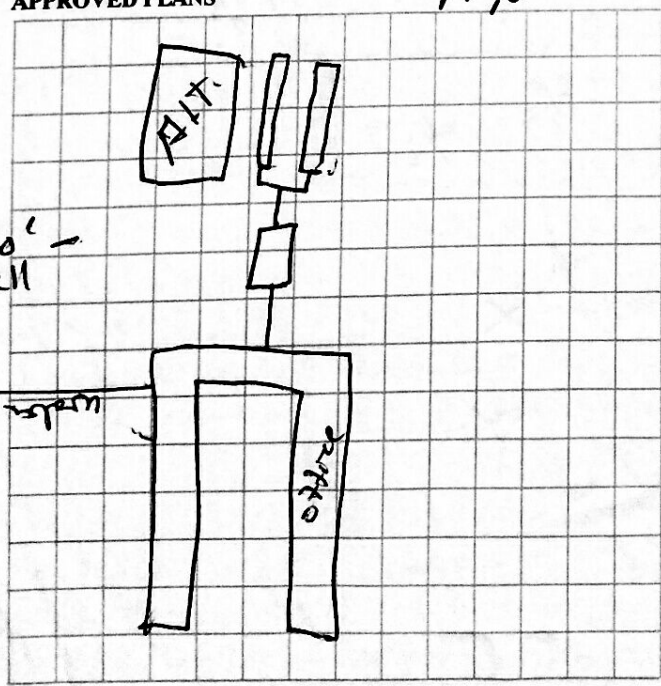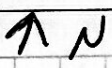

AS BUILT PLANS

