

T6S, R34E, Sec 5

SOUTHEASTERN DISTRICT HEALTH DEPARTMENT
INDIVIDUAL SEWAGE DISPOSAL INSTALLATION PERMIT

DATE 11/13/67

INSTALLATION FOR Norbert Darrel Smith AT Rio Vista Road; 1/4 mile N. of Chubbuck Rd
(name) (location, lot & blk. or street)

TOTAL NUMBER _____
Living Units/ Bedrooms/ People Served _____
Septic Tank 1 (FD) gal. Seepage Pit Field Drain Modified Field Drain Absorption Bed
FHA VA CONV WATER SUPPLY _____
NEW EXISTING Public/Private _____
Make or Dimensions 8'x4'x7 1/2' Square Footage (effective area) Approximately 400 sq ft.

DISTANCE OF INSTALLATION FROM
Property Lines: front 25 ft. back _____ ft. side _____ ft. well _____ ft.
canals or ditches _____ ft.
Foundation _____ ft. Nearest adjacent well _____ ft. Special construction conditions _____


Paid pd Bill _____ No fee _____

APPLICANT Norbert Darrel Smith
Signature

1331 Yellowstone
Address

This system will serve one mobile home

Property Line

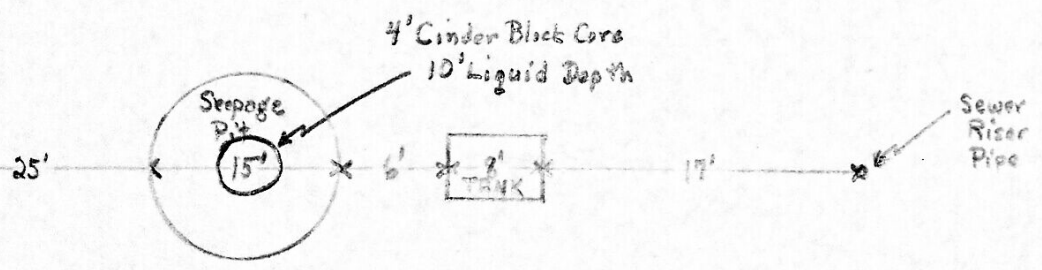

INSPECTED 4-9-68 BY Rulon S. Juelles
date sanitarian

APPROVED NOT APPROVED

Plan Approved
Rulon S. Juelles