

12W

Southeastern District Health Department

Jurisdiction
390

Fee Paid Y N
Amount Paid **\$350.00**
Receipt # **94841**
Permit # **172893**
Renewal Date _____

EHS # **58** / / / /
Date **4/3/08** / / / /
Travel Time **30** ✓ / / / /
Inspection Time **30** ✓ / / / /
EHS # _____ / / / /
Date _____ / / / /
Activity Code _____ / / / /
Office Time _____ / / / /

5/6/08
HH

APPLICATION & PERMIT VALID FOR ONE YEAR FROM DATE OF ISSUANCE

Exp. Date **1-7-2009**

Name **Bruce Wanner** Phone **339-1191** Property Address **2706 N. Main St, Pocatello, ID 83204**
Mailing Address **2706 N. Main** Legal Description: Lot Size (Acres) **.30**
City **Pocatello** ¼ Section _____ Section **22** Township **6 South** Range **34 East**
State **Idaho** Zip **83204** Lot # _____ Block # _____ Subdivision _____
Septic Tank Size **1000** gal. Est. Type **233** Effective Disposal Area **556** 444 Sq. Ft. Soil Type **B-2** Maximum Depth Below Ground Surface **8'** ~~X~~ Bedrooms **3** ~~2~~

INSTALLATION MUST BE BY LICENSED SEWER INSTALLER OR HOME/LANDOWNER

Date **Jan 7, 2008** EHS Signature **Ken Keller** EHS # **58** Applicant Signature **Bruce Wanner**
Remarks **An old well was located under the deck. I returned Mr. Wanner to Idaho Department of Water Resources for proper sealing of the well under his deck. He is on City of Pocatello Water. Mr. Wanner filled the well casing with Bentonite. See receipt attached. Drain field must be minimum 100' from any other (unsealed) wells.**


INSPECTION: THE DISTRICT HEALTH DEPARTMENT SHALL BE NOTIFIED OF INSTALLATION 48 HOURS PRIOR TO BACKFILLING

Septic Tank Size **1000** gal. Standpipe **Y X N** Manhole Depth **7'** Depth Below Ground Surface **8'** Rock Under Pipe **6"** No. & Type of Dome **NA**
Effective Disposal Area **500** sq. ft. Code **A** INSTALLATION **APPROVED X DISAPPROVED** Installer **FM Construction** Installer # **27531**
EHS Signature **Ken Keller** Date **May 1, 2008** EHS # **58**
Remarks **Due to the depth of the gravelless trench system installed (~8') an absorption bed will be required. See the attached Approved plans. Mrs. Wanner changed the number of bedrooms from 3 to 2 on 3-3-08. See septic application.**

WATER SYSTEM

Min. Distances Per Regs. From Septic System **Y X N** Water System **Public X Private**

APPROVED PLANS

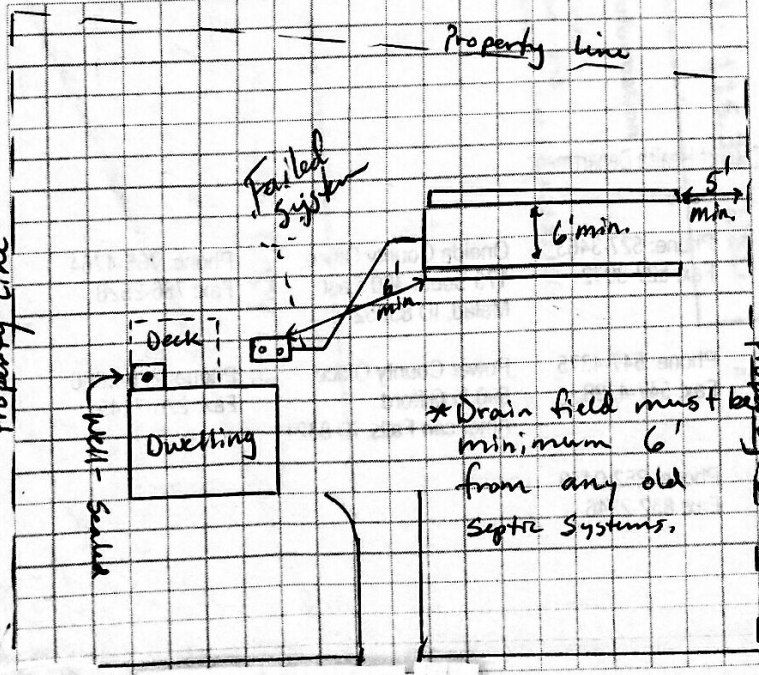

AS BUILT PLANS

