

GW 16W

Jurisdiction
3900

Southeastern District Health Department

Fee Paid Y N
Amount Paid 125 /
Receipt # 56740
Permit # 174292
Renewal Date 7/2009

EHS # 65 / / / / /
Date 3/26/09 / / / / /
Travel Time 60 / / / / /
Inspection Time 60 / / / / /

APPLICATION & PERMIT VALID FOR ONE YEAR FROM DATE OF ISSUANCE 223-6272 Bill Exp. Date 12/2/2009

Name ARON Floyd Phone 390-5868 Property Address 1390 W. Sypson

Mailing Address 1390 W. Sypson Legal Description: Lot Size (Acres) 2+

City Pocatello Section 2 Township 6 Range 34

State ID Zip 83205 Lot # Block # Subdivision

Septic Tank Size 1500 gal. Est. Type 232 Effective Disposal Area 768 sq. Ft. Soil Type B-2 Maximum Depth Below Ground Surface 4' # Bedrooms 6

INSTALLATION MUST BE BY LICENSED SEWER INSTALLER OR HOME/LANDOWNER

Date 12/2/2008 EHS Signature Craig Maden EHS # 65 Applicant Signature Bill Crumpton

Remarks

Permit application is attached hereto and is incorporated by reference herein.

Septic Tank Size 1000 gal. Precast Standpipe Y N Manhole Depth 8" Depth Below Ground Surface 2' Rock Under Pipe No. & Type of Dome 48

Effective Disposal Area 768 sq. ft. Code G INSTALLATION APPROVED DISAPPROVED Installer Jerry Stewart Installer # 32791


EHS Signature Craig Maden Date 3-26-09 EHS # 65

Remarks manhole location: 8' north of easement. Pump septic tank every 3 years.

WATER SYSTEM

Min. Distances Per Regs. From Septic System Y N Water System Public Private

APPROVED PLANS

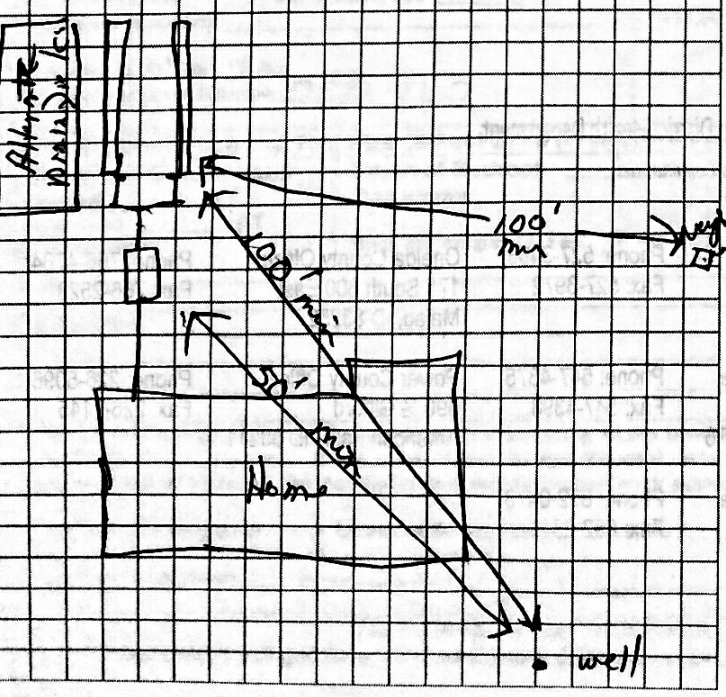

AS BUILT PLANS

