

60160

Jurisdiction
300

Southeastern District Health Department

Fee Paid Y N
Amount Paid \$500.00
Receipt # 864711
Permit # 175049
Renewal Date

EHS # 58 / Date 5/19/10 / Travel Time 45 ✓ / Inspection Time 60 ✓
EHS # / Date / Activity Code / Office Time

APPLICATION & PERMIT VALID FOR ONE YEAR FROM DATE OF ISSUANCE

Exp. Date 8/31/2010

Name	HEINZ FOODS	Phone	238-3000	Property Address	221 ORE-IDA CT., POCA TELLO, ID 83202
Mailing Address	221 ORE-IDA CT.,		Legal Description: Lot Size (Acres)	45	
City	POCA TELLO		Section	10 AND 11	
State	IDAH O	Zip	83202	Township	6 SOUTH
Septic Tank Size	750 gal.	Est. Type	232	Range	34 EAST
Effective Disposal Area	134 Sq. Ft.	Soil Type	B-2	Subdivision	
Maximum Depth Below Ground Surface	4'		#Bedrooms	3 EMPLOYEES	

INSTALLATION MUST BE BY LICENSED SEWER INSTALLER OR HOME/LANDOWNER

Date 8/31/2009 EHS Signature Ken Keller EHS # 58 Applicant Signature [Signature]



Remarks Drain field and replacement area must be minimum 100' from any well, minimum 25' from any water line minimum 5' from property line. Septic tank must be minimum 50' from any well, minimum 25' from any water line. Install septic system according to IDAPA 58.01.03, Rules for Individual Onsite Septic Systems. Septic system must be installed by a licensed septic system installer, licensed in the state of Idaho.

Permit application is attached hereto and is incorporated by reference herein.

Septic Tank Size	Robertson	Standpipe	Y <input type="checkbox"/> N <input checked="" type="checkbox"/>	Manhole Depth	18"	Depth Below Ground Surface	3'6"	Rock Under Pipe	NA	No. & Type	19 Quick 4 of Dome Infiltrators
Effective Disposal Area	300 sq. ft.	Code	G	INSTALLATION	APPROVED <input checked="" type="checkbox"/> DISAPPROVED <input type="checkbox"/>	Installer	Nalder's EXCAVATION 24646				
EHS Signature	<u>Ken Keller</u>		Date	<u>May 19, 2010</u>		EHS #	58				
Remarks	<u>Recommend your septic tank be pumped at least every 3 years.</u>										

WATER SYSTEM

Min. Distances Per Regs. From Septic System Y N Water System Public Private

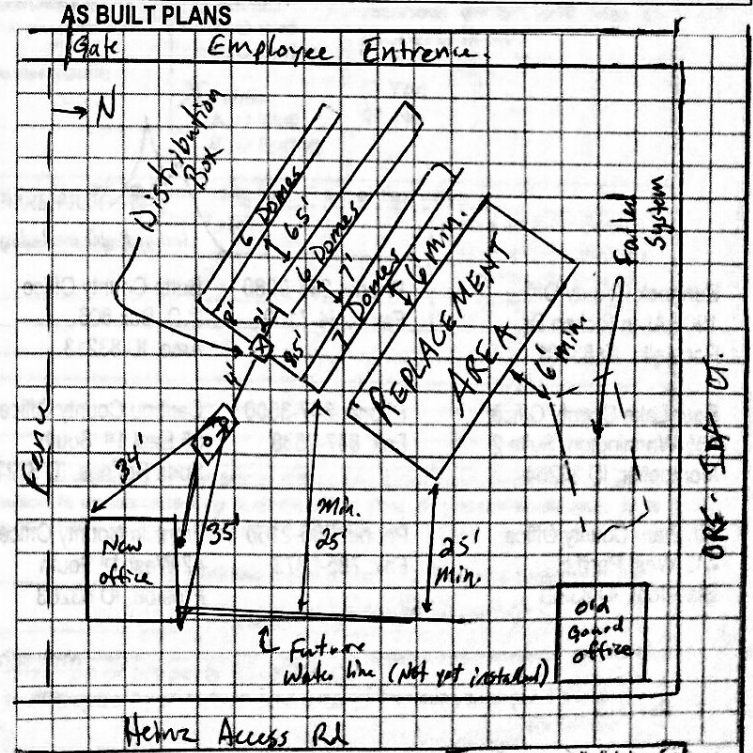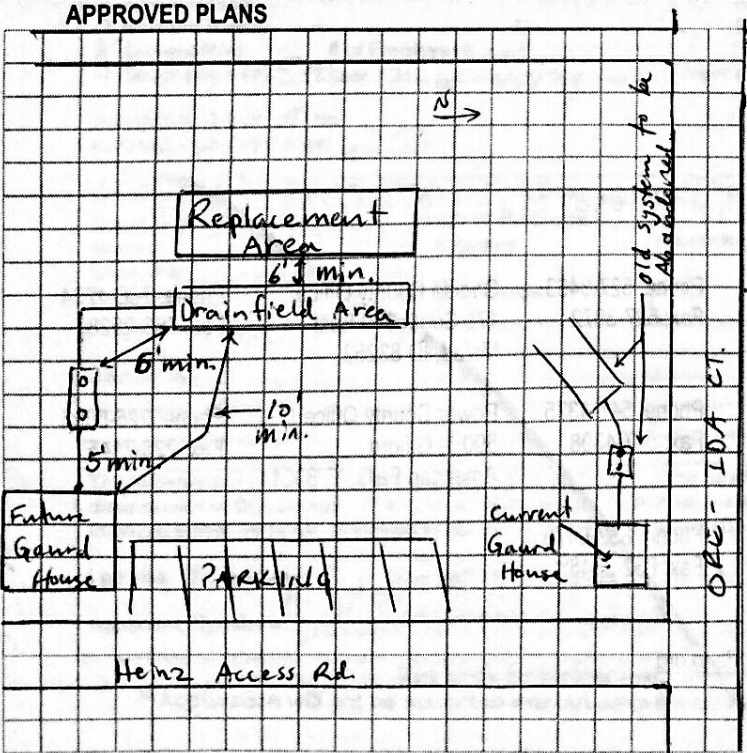

To view a copy of the Technical Guidance Manual go to www.sdhidaho.org

* Not to Scale