

SOUTHEASTERN DISTRICT HEALTH DEPARTMENT  
INDIVIDUAL SEWAGE DISPOSAL INSTALLATION PERMIT

Date 25 March '75

Permit No. \_\_\_\_\_  
Installation for Kenneth Lyon at NE 1/4 NW 1/4 Section 33 T6S R34E  
(Name) (Legal description of property)

Address of Installation \_\_\_\_\_

No. Living Units 1 Bedrooms 4 People Served 5 Water Supply--Private  Public \_\_\_\_\_ Applicant is: Owner  Contractor \_\_\_\_\_ Other \_\_\_\_\_

FHA \_\_\_\_\_ FARM HOME \_\_\_\_\_ VA \_\_\_\_\_ CONV. \_\_\_\_\_ EXISTING \_\_\_\_\_ NO. \_\_\_\_\_

Septic Tank 1000 gal. may be 1000 gal Perc. Rate 36 Min./in. Min. Depth to Ground Water \_\_\_\_\_ ft.

Effluent Disposal: Effective Area Required 1000 sq. ft. Soil System: \_\_\_\_\_ Soil Profile \_\_\_\_\_

Field Drain  Absorption Bed \_\_\_\_\_ Standard \_\_\_\_\_ Modified \_\_\_\_\_ Seepage Pit \_\_\_\_\_ Dimensions \_\_\_\_\_

Distance from Disposal Area to:

Property Lines: Front 10 ft. Back 10 ft. Side 10 ft. Dwelling Foundation 20 ft. Well 100 ft.

Surface Water \_\_\_\_\_ ft. Nearest Neighbor's Well \_\_\_\_\_ ft. Plot Plan Submitted and Approved \_\_\_\_\_ Septic Tank 5 ft.

Remarks: call before backfilling

Applicant Kenneth Lyon Paid \_\_\_\_\_ Bill \_\_\_\_\_ No Fee

Address Box 4392 Pocatello Permit Issued by William H. Minkauer

INSPECTION: Septic Tank Size 1000 Standpipe \_\_\_\_\_ Depth to Manhole \_\_\_\_\_

Distance from Septic Tank to: Dwelling Foundation \_\_\_\_\_ ft. Well \_\_\_\_\_ ft. Nearest Neighbor's Well \_\_\_\_\_ ft.

Effluent Disposal: Effective Area 1000 sq. ft.

Field Drain \_\_\_\_\_ Absorption Bed  Standard  Modified \_\_\_\_\_ Seepage Pit \_\_\_\_\_ Dimensions \_\_\_\_\_

Pipe Size \_\_\_\_\_ No. of Lines \_\_\_\_\_ Length \_\_\_\_\_ Depth \_\_\_\_\_

Distance from Disposal Area to:


Property Lines: Front \_\_\_\_\_ ft. Back \_\_\_\_\_ ft. Side \_\_\_\_\_ ft. Dwelling Foundation \_\_\_\_\_ ft. Well \_\_\_\_\_ ft.

Surface Water \_\_\_\_\_ ft. Water Service Piping \_\_\_\_\_ ft. Depth to Gravel \_\_\_\_\_ ft. Nearest Neighbor's Well \_\_\_\_\_ ft.

Approved  Not Approved \_\_\_\_\_ Inspected By Phone 12 May 75 by W.H. Minkauer Installed by Richard Browning

Remarks \_\_\_\_\_

Applicant's sketch of house, proposed sewage layout and all adjacent wells (dimension between all components) --

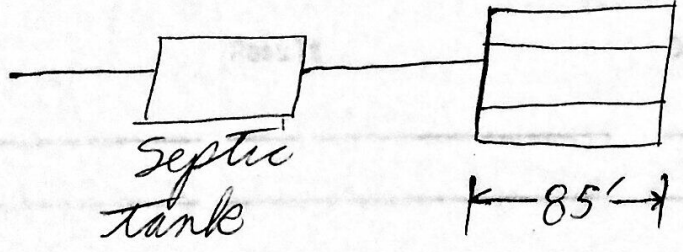

4 drain lines 85' long  
changed to a  
absorption bed  
of 20' by 50' - 2 May 1975

Install according to