

JURISDICTION  
300

SOUTHEASTERN DISTRICT HEALTH DEPARTMENT  
465 MEMORIAL DRIVE  
POCATELLO, ID

6W, 6W  
FEE PD  Y  N  
PERMIT # 85162

TRAVEL TIME: 30  
INSPECTION TIME: 45

200-315

\*\*APPLICATION AND PERMIT VALID FOR ONE YEAR FROM DATE OF ISSUANCE

NAME MARK LOWE		PHONE 232-2065	PROPERTY ADDRESS 13596 W. MEADOW LARK LN		
MAILING ADDRESS: 13596 W. MEADOW LARK LN		LEGAL DESCRIPTION: LOT SIZE (ACRES) _____ ¼ SECTION NW SECTION 33 TOWNSHIP 65 RANGE 34E			
STREET/P.O. BOX		LOT # _____ BLOCK # _____ SUBDIVISION _____			
CITY POCATELLO		PARCEL # R3853030200 FROM TAX ASSESSOR'S OFFICE			
STATE ID	ZIP 83204				
SEPTIC TANK SIZE EXISTING gal.	EST TYPE 237	EFFECTIVE DISPOSAL AREA 328 SQ.FT.	SOIL TYPE B-2	MAXIMUM DEPTH BELOW GROUND SURFACE 4'	# BEDROOMS 5

INSTALLATION MUST BE BY LICENSED SEWER INSTALLER OR HOME/LANDOWNER

EHS SIGNATURE <i>Steve J. Ro</i>	EHS # 64	APPLICANT SIGNATURE <i>Mark Lowe</i>	DATE 6-29-94
REMARKS Addition to existing system - 66 ft. of WELTRATOR = 330 sq ft			

INSPECTION

THE DISTRICT HEALTH DEPARTMENT SHALL BE NOTIFIED OF INSTALLATION 48 HOURS PRIOR TO INSTALLATION

SEPTIC TANK SIZE 1000 gal	STANDPIPE: ( ) YES (X) NO	MANHOLE DEPTH 3 ft	DEPTH BELOW GROUND SURFACE 4 ft	ROCK UNDER PIPE Infiltration
EFFECTIVE DISPOSAL AREA 330 sq. ft.	INSTALLATION APPROVED <input checked="" type="checkbox"/> DISAPPROVED _____	INSTALLER J.J. Construction		INSTALLER # 903


EHS SIGNATURE <i>[Signature]</i>	DATE 05/15/95	EHS # 69
REMARKS no standpipe		

WATER SYSTEM

PLANS APPROVED YES <input checked="" type="checkbox"/> NO _____	SAMPLE COLLECTED BY _____	DATE _____	STATE LAB INDICATES INTESTINAL BACTERIA WERE _____ WERE NOT _____ FOUND
MIN. DISTANCES PER STANDARDS/REGS. YES _____ NO _____	CHEMICAL PARAMETERS TESTED WITHIN LIMITS YES _____ NO _____	SYSTEM PUBLIC _____ PRIVATE <input checked="" type="checkbox"/>	

WELL (SPRING) APPEARS TO MEET CONSTRUCTION STANDARDS AT TIME OF INSPECTION (X) YES ( ) NO	EHS SIGNATURE _____	EHS # _____
REMARKS Infiltrators		

APPROVED PLANS

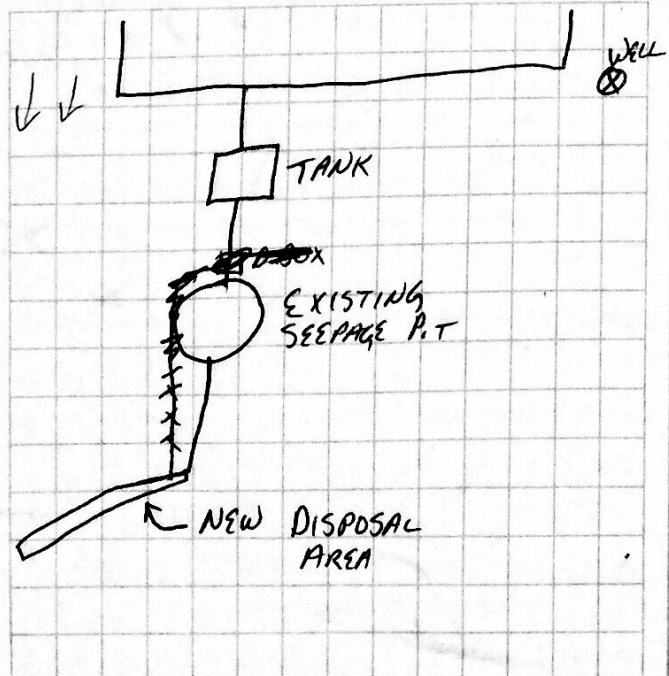

AS BUILT PLANS

