

JURISDICTION
3900

65
5/10/06

SOUTHEASTERN DISTRICT HEALTH DEPARTMENT
1901 ALVIN RICKEN DRIVE POCATELLO, ID 83201

7171
FEE PD Y N
PERMIT # 168706

TRAVEL TIME: 60
INSPECTION TIME: 60

****APPLICATION AND PERMIT VALID FOR ONE YEAR FROM DATE OF ISSUANCE**

NAME Bob Rowland		PHONE 238-1259	PROPERTY ADDRESS Rowland Road	
MAILING ADDRESS		LEGAL DESCRIPTION: LOT SIZE (ACRES)		
STREET/PO BOX 1141 Rowland Road		1/4 SECTION	SECTION 7	TOWNSHIP 6S RANGE 34E
CITY Pocatello		LOT # 2	BLOCK #	SUBDIVISION
STATE ID		PARCEL # RPD0403-06 FROM TAX ASSESSOR'S OFFICE		
SEPTIC TANK SIZE 900 gal.	EST TYPE 232	EFFECTIVE DISPOSAL AREA 444 SQ. FT.	SOIL TYPE B-2	MAXIMUM DEPTH BELOW GROUND SURFACE 4
				# BEDROOMS 2

INSTALLATION MUST BE BY LICENSED SEWER INSTALLER OR HOME/LANDOWNER

DATE 10-18-05	EHS SIGNATURE Craig Madson	EHS# 65	APPLICANT SIGNATURE Bob Rowland
REMARKS			

INSPECTION

THE DISTRICT HEALTH DEPARTMENT SHALL BE NOTIFIED OF INSTALLATION 48 HOURS PRIOR TO BACKFILLING

SEPTIC TANK SIZE 1000 gal.	STANDPIPE: () YES (<input checked="" type="checkbox"/>) NO	MANHOLE DEPTH 8"	DEPTH BELOW GROUND SURFACE 3'	ROCK UNDER PIPE 24X4 INfiltrator
EFFECTIVE DISPOSAL AREA 444 sq. ft.	INSTALLATION APPROVED <input checked="" type="checkbox"/> DISAPPROVED <input type="checkbox"/>	INSTALLER Kooper Exx		INSTALLER # 28084


EHS SIGNATURE Craig Madson	DATE 5/10/2006	CODE G	EHS # 65
REMARKS			

WATER SYSTEM


PLANS APPROVED YES <input checked="" type="checkbox"/> NO <input type="checkbox"/>	SAMPLE COLLECTED BY	DATE	STATE LAB INDICATES INTESTINAL BACTERIA WERE <input type="checkbox"/> WERE NOT <input type="checkbox"/> FOUND
MIN. DISTANCES PER STANDARDS/REGS. YES <input checked="" type="checkbox"/> NO <input type="checkbox"/>	CHEMICAL PARAMETERS TESTED WITHIN LIMITS YES <input type="checkbox"/> NO <input type="checkbox"/>		SYSTEM PUBLIC <input type="checkbox"/> PRIVATE <input checked="" type="checkbox"/>

WELL (SPRING) APPEARS TO MEET CONSTRUCTION STANDARDS AT TIME OF INSPECTION () YES () NO	EHS SIGNATURE	EHS#
REMARKS		

APPROVED PLANS

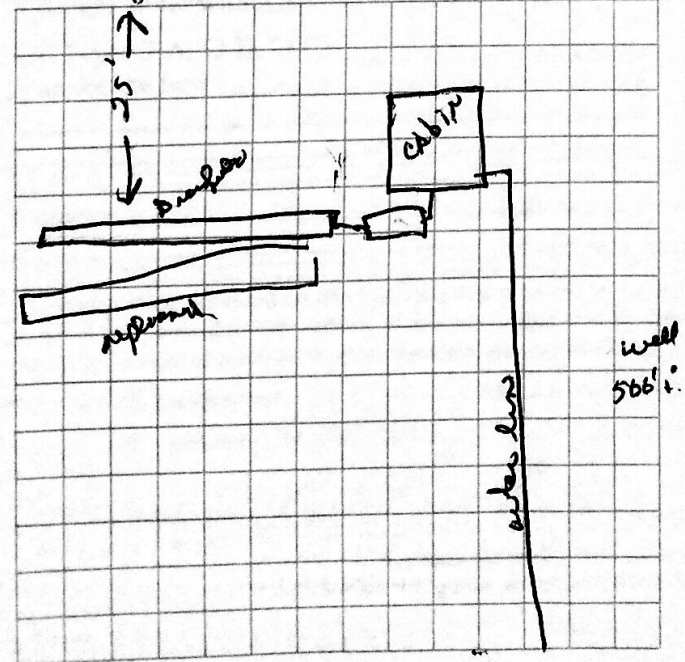

AS BUILT PLANS

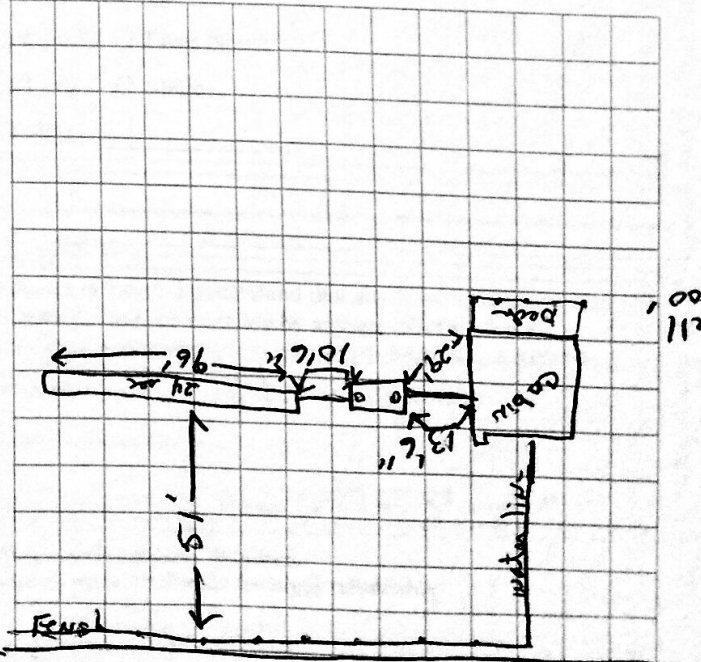

Rowland Road

Rowland Road