

11-9-00

GW, GW

#6295

JURISDICTION 300

SOUTHEASTERN DISTRICT HEALTH DEPARTMENT
1901 ALVIN RICKEN DRIVE POCATELLO, ID 83201

FEE PD Y N
PERMIT # 150677

TRAVEL TIME: 45
INSPECTION TIME: 60

****APPLICATION AND PERMIT VALID FOR ONE YEAR FROM DATE OF ISSUANCE**

NAME Reed Hurst		PHONE B ^s - 287-2588	PROPERTY ADDRESS 11624 Buffalo		
MAILING ADDRESS:		287-5310			
STREET/PO BOX 11624		LEGAL DESCRIPTION: LOT SIZE (ACRES) 4			
CITY Poc		¼ SECTION _____ SECTION 2		TOWNSHIP 6 RANGE 34	
STATE Id		LOT # _____ BLOCK # _____		SUBDIVISION _____	
ZIP 83202		PARCEL # R3853001402 FROM TAX ASSESSOR'S OFFICE			
SEPTIC TANK SIZE existing gal.	EST TYPE 233	EFFECTIVE DISPOSAL AREA 556 SQ.FT.	SOIL TYPE B-2	MAXIMUM DEPTH BELOW GROUND SURFACE Replacement	# BEDROOMS 3

INSTALLATION MUST BE BY LICENSED SEWER INSTALLER OR HOME/LANDOWNER

EHS SIGNATURE Craig Madison	EHS # 65	APPLICANT SIGNATURE Reed Hurst	DATE 10-25-00
REMARKS			

INSPECTION
THE DISTRICT HEALTH DEPARTMENT SHALL BE NOTIFIED OF INSTALLATION 48 HOURS PRIOR TO BACKFILLING

SEPTIC TANK SIZE existing gal	STANDPIPE: () YES <input checked="" type="checkbox"/> NO	MANHOLE DEPTH 2'	DEPTH BELOW GROUND SURFACE 3'-4'	ROCK UNDER PIPE Infiltrators?
EFFECTIVE DISPOSAL AREA 600 sq. ft.	INSTALLATION APPROVED <input checked="" type="checkbox"/> DISAPPROVED _____	INSTALLER Grant mikes	INSTALLER # 920	

EHS SIGNATURE Craig Madison	DATE 11-9-00	CODE A	EHS # 65
REMARKS			



WATER SYSTEM

PLANS APPROVED YES <input checked="" type="checkbox"/> NO _____	SAMPLE COLLECTED BY	DATE	STATE LAB INDICATES INTESTINAL BACTERIA WERE _____ WERE NOT _____ FOUND
MIN. DISTANCES PER STANDARDS/REGS. YES <input checked="" type="checkbox"/> NO _____	CHEMICAL PARAMETERS TESTED WITHIN LIMITS YES _____ NO _____		SYSTEM PUBLIC _____ PRIVATE <input checked="" type="checkbox"/>
WELL (SPRING) APPEARS TO MEET CONSTRUCTION STANDARDS AT TIME OF INSPECTION <input checked="" type="checkbox"/> YES () NO	EHS SIGNATURE _____ EHS # _____		

REMARKS

APPROVED PLANS **Buffalo ↑ ~**

AS BUILT PLANS **Buffalo ↑ ~**

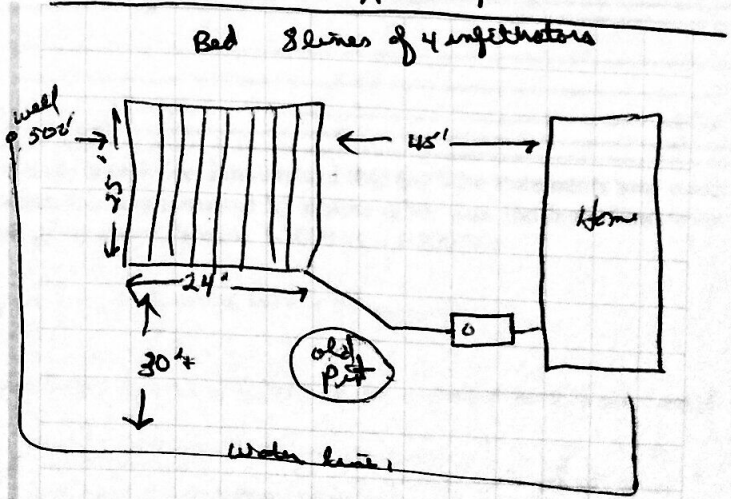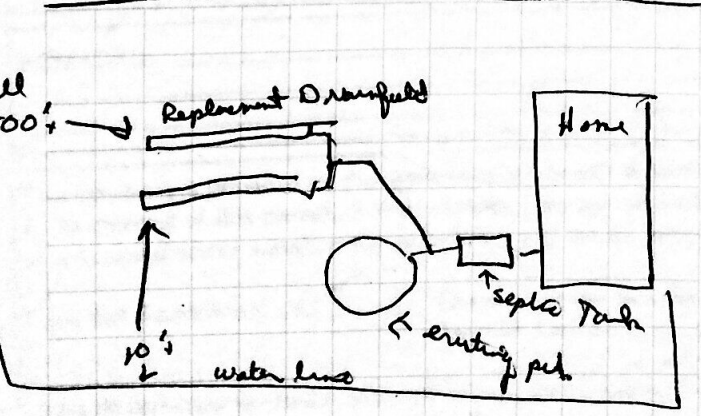

25
1004
500
600