

Home 237-5542

SOUTHEASTERN DISTRICT HEALTH DEPARTMENT
INDIVIDUAL SEWAGE DISPOSAL INSTALLATION PERMIT

Permit No. _____
Installation for PETE ANESTOS at 5 1/2 5 1/2 SW 1/4 Sec 17 T6S R35E
(Name) (Legal description of property)

Date 26 June 1974

Address of Installation 1/3 mi No. of intersection of PARKS + LOC. CREEK Rd.

No. Living Units 1 Bedrooms 3 People Served 3 Water Supply--Private _____ Public ✓ Applicant is: Owner _____ Contractor ✓ Other _____

FHA _____ FARM HOME _____ VA _____ CONV. _____ EXISTING _____ NO. _____

Septic Tank 1000 gal. Perc. Rate 30 Min./in. Min. Depth to Ground Water _____ ft.

Effluent Disposal: Effective Area Required 750 sq. ft. Soil System: _____
Field Drain ✓ Absorption Bed _____ Standard ✓ Modified _____ Seepage Pit _____ Dimensions _____

Distance from Disposal Area to:
Property Lines: Front 10 ft. Back 10 ft. Side 10 ft. Dwelling Foundation 15 ft. Well 100 ft.
Surface Water 4 ft. Nearest Neighbor's Well 100 ft. Plot Plan Submitted and Approved ✓ Septic Tank _____ ft.

Remarks: Do NOT BACKFILL WITHOUT PRIOR INSPECTION

Applicant Robert D Henderson Paid _____ Bill _____ No Fee ✓

Address _____ Permit Issued by Tom Hopkins

INSPECTION: Septic Tank Size _____ Standpipe _____ Depth to Manhole _____

Distance from Septic Tank to: Dwelling Foundation _____ ft. Well _____ ft. Nearest Neighbor's Well _____ ft.

Effluent Disposal: Effective Area _____ sq. ft.
Field Drain ✓ Absorption Bed _____ Standard _____ Modified _____ Seepage Pit _____ Dimensions _____

Pipe Size _____ No. of Lines _____ Length _____ Depth _____


Distance from Disposal Area to:
Property Lines: Front _____ ft. Back _____ ft. Side _____ ft. Dwelling Foundation _____ ft. Well _____ ft.
Surface Water _____ ft. Water Service Piping _____ ft. Depth to Gravel _____ ft. Nearest Neighbor's Well _____ ft.

Approved ✓ Not Approved _____ Inspected 29 Oct 74 by Bill Marlowe Installed by Campbell Excavating
(Date)

Remarks _____

Applicant's sketch of house, proposed sewage layout and all adjacent wells (dimension between all components) --

3. 85'-0 lines x 3'-0 wide with min 6'-0 between lines all interconnected

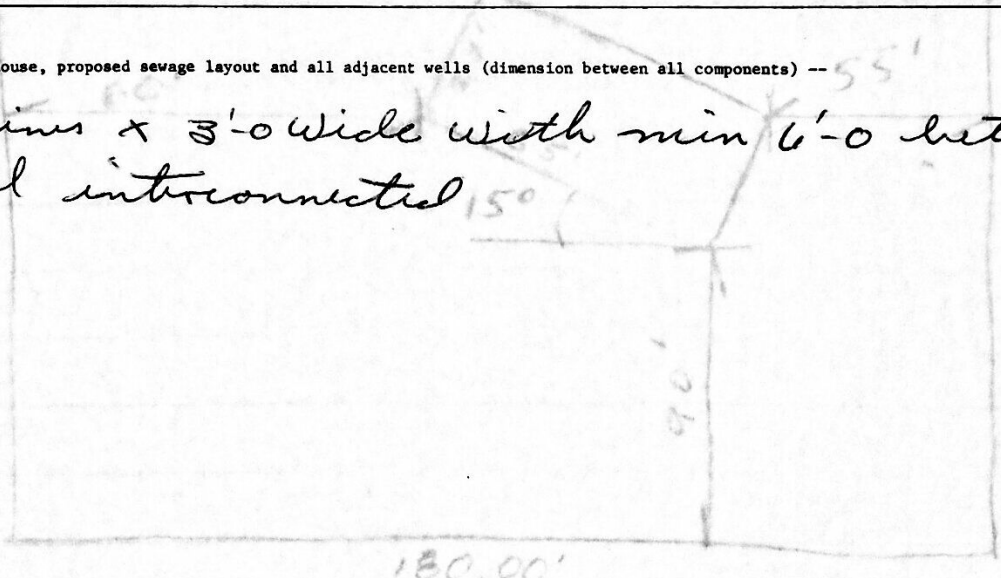

3. Bedroom
3 Bath

Install according to _____