


SOUTHEASTERN DISTRICT HEALTH DEPARTMENT
INDIVIDUAL SEWAGE DISPOSAL INSTALLATION PERMIT

Permit No. _____ Date 7 July 1975
 Installation for Robert Chase at NW 1/4 SW 1/4 Sec 18 T6S R35E
 (Name) (Legal description of property)
 Address of Installation 5 miles up Por. Cr Rd
 No. Living Units 1 Bedrooms 3 People Served 4 Water Supply--Private Public Applicant is: Owner Contractor Other
 FHA FARM HOME VA CONV. EXISTING NO.

Septic Tank 1000 gal. Perc. Rate 12 in./in. Min. Depth to Ground Water _____ ft.
 Effluent Disposal: Effective Area Required 500 sq. ft. Soil System: _____ Soil Profile _____
 Field Drain Absorption Bed _____ Standard Modified _____ Seepage Pit _____ Dimensions _____
 Distance from Disposal Area to:
 Property Lines: Front 10 ft. Back 10 ft. Side 10 ft. Dwelling Foundation 20 ft. Well 100 ft.
 Surface Water 150 ft. Nearest Neighbor's Well _____ ft. Plot Plan Submitted and Approved _____ Septic Tank 5 ft.
 Remarks: Have system inspected and approved before backfilling
 Applicant R. Chase Paid _____ Bill _____ No Fee _____
 Address _____ Permit Issued by William H. Maibauer

INSPECTION: Septic Tank Size 1000 Standpipe 4' Depth to Manhole 1 1/2'
 Distance from Septic Tank to: Dwelling Foundation 10' ft. Well >100' ft. Nearest Neighbor's Well 100 ft.
 Effluent Disposal: Effective Area 500 sq. ft.
 Field Drain Absorption Bed _____ Standard Modified _____ Seepage Pit _____ Dimensions _____
 Pipe Size 4" No. of Lines 2 Length 93' Depth 1'-2'
 Distance from Disposal Area to:
 Property Lines: Front _____ ft. Back _____ ft. Side _____ ft. Dwelling Foundation _____ ft. Well _____ ft.
 Surface Water _____ ft. Water Service Piping _____ ft. Depth to Gravel _____ ft. Nearest Neighbor's Well _____ ft.
 Approved Not Approved _____ Inspected 14 July 75 by W. H. Maibauer Installed by Dick Stanger
 Remarks have a septic tank pumped every 3 years

Applicant's sketch of house, proposed sewage layout and all adjacent wells (dimension between all components) --

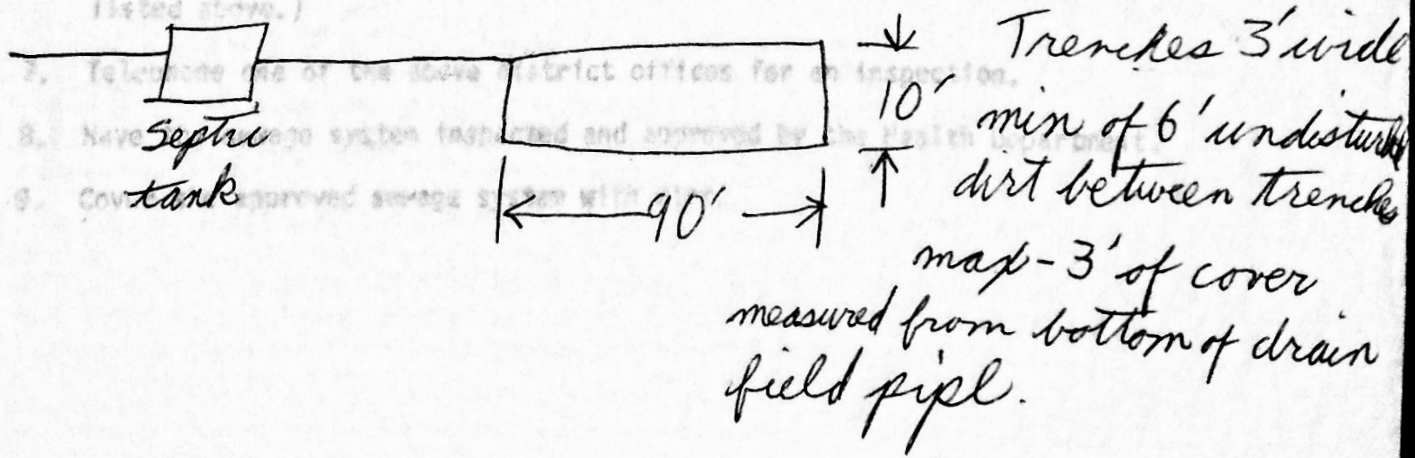

(See attached letter
04/22/75 #25-03)