

JURISDICTION
300
TRAVEL TIME: 30
INSPECTION TIME: 45

SOUTHEASTERN DISTRICT HEALTH DEPARTMENT
465 MEMORIAL DRIVE
POCATELLO, ID

FEE PD 90 Y N
PERMIT # 124375

Code 6

APPLICATION AND PERMIT VALID FOR ONE YEAR FROM DATE OF ISSUANCE

NAME: *Mark/Debra Warren* PHONE: *234-0293* PROPERTY ADDRESS: *9215(3) Ridgewood*

MAILING ADDRESS: *9217 No. Ridgewood* LEGAL DESCRIPTION: LOT SIZE (ACRES) *1 acre*

STREET/P.O. BOX: CITY: *Pocatello* 1/4 SECTION *SW* SECTION *18* TOWNSHIP *6* RANGE *35*

STATE: *IDAHO* ZIP: *83201* PARCEL # *R3851008604* FROM TAX ASSESSOR'S OFFICE

SEPTIC TANK SIZE: *1000 gal.* EST TYPE: *232* EFFECTIVE DISPOSAL AREA: *555* SQ.FT. SOIL TYPE: *B-2* MAXIMUM DEPTH BELOW GROUND SURFACE: *4ft* # BEDROOMS: *3*

INSTALLATION MUST BE BY LICENSED SEWER INSTALLER OR HOME/LANDOWNER

EHS SIGNATURE: *[Signature]* EHS #: *109* APPLICANT SIGNATURE: *Debra Warren* DATE: *11-17-97*

REMARKS: *Do Not Inspect until receive Parcel Number! SEE LETTER [Signature] 10-17-97 cm*

INSPECTION

THE DISTRICT HEALTH DEPARTMENT SHALL BE NOTIFIED OF INSTALLATION 48 HOURS PRIOR TO BACKFILLING

SEPTIC TANK SIZE: *1000 gal* STANDPIPE: () YES (X) NO MANHOLE DEPTH: *24 in* DEPTH BELOW GROUND SURFACE: *4ft-2ft* ROCK UNDER PIPE: *19 Infiltrators*

EFFECTIVE DISPOSAL AREA: *556 sq. ft.* INSTALLATION: APPROVED DISAPPROVED INSTALLER: *Ziebach* INSTALLER #: *935*

EHS SIGNATURE: *[Signature]* DATE: *11/03/98* EHS #: *69*

REMARKS: *Don't place greater than 4ft of Cores over drainfield or build on it or Drive on it. They have deeded another 1/2 acre to 1/2 ac lot so now it (1) full access.*

WATER SYSTEM


PLANS APPROVED: YES NO SAMPLE COLLECTED BY: DATE: STATE LAB INDICATES INTESTINAL BACTERIA WERE WERE NOT FOUND

MIN. DISTANCES PER STANDARDS/REGS.: YES NO CHEMICAL PARAMETERS TESTED: WITHIN LIMITS YES NO SYSTEM: PUBLIC PRIVATE

WELL (SPRING) APPEARS TO MEET CONSTRUCTION STANDARDS AT TIME OF INSPECTION: () YES () NO *City Water* EHS SIGNATURE: EHS #:

REMARKS:

APPROVED PLANS

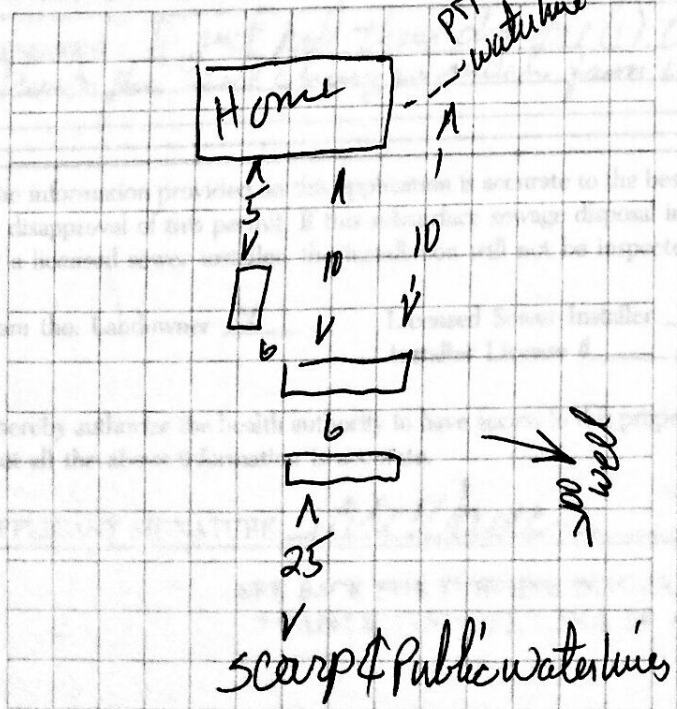

AS BUILT PLANS

