

CW JAW

Southeastern District Health Department

Jurisdiction

300

Fee Paid Y N
 Amount Paid 200.00
 Receipt # 4498 /
 Permit # 190234
 Renewal Date _____

EHS # <u>58 / 58 /</u>	EHS # _____
Date <u>10/12/06 / 10/12/06 /</u>	Date _____
Travel Time <u>30 / 30 /</u>	Activity Code _____
Inspection Time <u>30 / 30 /</u>	Office Time _____

APPLICATION & PERMIT VALID FOR ONE YEAR FROM DATE OF ISSUANCE

Exp. Date 8/7/2007

Name <u>ERIC JOHNSON</u>	Phone <u>234-3750</u>	Property Address <u>5575 Moonlight Mine Rd. Pocatello, ID, 83201</u>
Mailing Address <u>5575 Moonlight Mine Rd.</u>	Legal Description: Lot Size (Acres) <u>6</u>	
City <u>Pocatello</u>	1/4 Section _____	Section <u>14</u> Township <u>6 South</u> Range <u>35 East</u>
State <u>Idaho</u> Zip <u>83201</u>	Lot # _____	Block # _____ Subdivision _____
Septic Tank Size <u>Existing 1000 gal.</u>	Est. Type <u>232</u>	Effective Disposal Area <u>333</u> Sq. Ft.
		Soil Type <u>B-2</u>
		Maximum Depth Below Ground Surface <u>4'</u>
		# Bedrooms <u>Shop with Toilet and Shower.</u>

INSTALLATION MUST BE BY LICENSED SEWER INSTALLER OR HOME/LANDOWNER



Date <u>Aug. 7, 2006</u>	EHS Signature <u>Ken Keller</u>	EHS # <u>58</u>	Applicant Signature <u>Eric Johnson</u>
Remarks <u>Drainfield, new addition, and replacement area must be minimum 100' from any well. May use existing septic tank, shop will not have kitchen waste water. Shop to have toilet, sink and shower. 576 ft² existing effective disposal area installed. 333 ft² effective disposal required for addition of shop with toilet, & shower (150 gallons per day). Install drainfield perpendicular to slope.</u>			

INSPECTION: THE DISTRICT HEALTH DEPARTMENT SHALL BE NOTIFIED OF INSTALLATION 48 HOURS PRIOR TO BACKFILLING

Septic Tank Size <u>Existing 1000 gal.</u>	Standpipe <u>Y</u> <u>N</u> <u>X</u>	Manhole Depth <u>2'</u>	Depth Below Ground Surface <u>3'6"</u>	Rock Under Pipe <u>18 Quick 4" Infiltrators</u>
Effective Disposal Area <u>339</u> sq. ft.	Code <u>G</u>	INSTALLATION <u>APPROVED</u> <input checked="" type="checkbox"/> <u>DISAPPROVED</u> _____	Installer <u>Koger Excavation</u>	Installer # <u>28084</u>
EHS Signature <u>Ken Keller</u>	Date <u>Oct 12, 2006</u>	EHS # <u>58</u>	Remarks <u>Existing drainfield accounts for 576 ft² of effective disposal area. New (additions) to drainfield accounts for 339 ft² of effective disposal area for a total of 915 ft² effective disposal area for entire septic system</u>	

WATER SYSTEM

Min. Distances Per Regs. From Septic System Y X N Water System Public Private

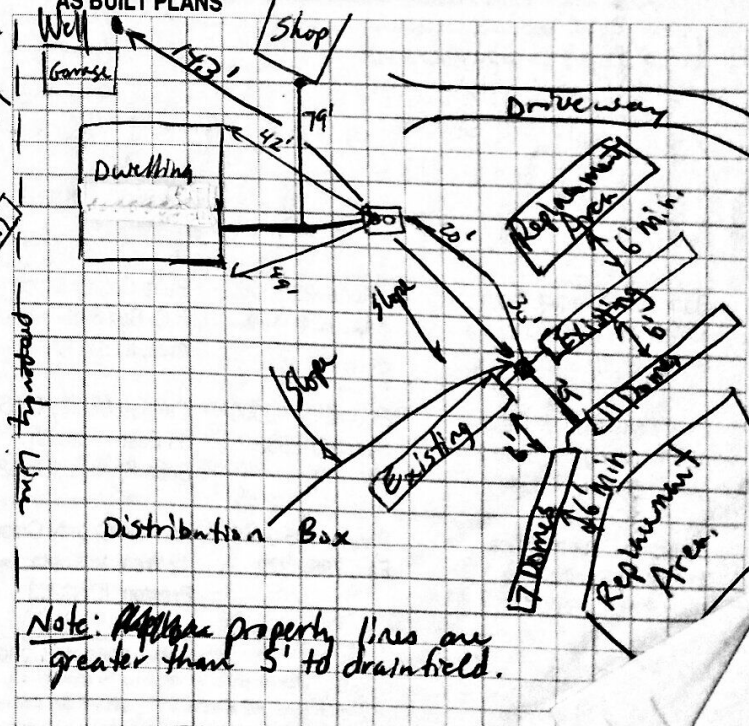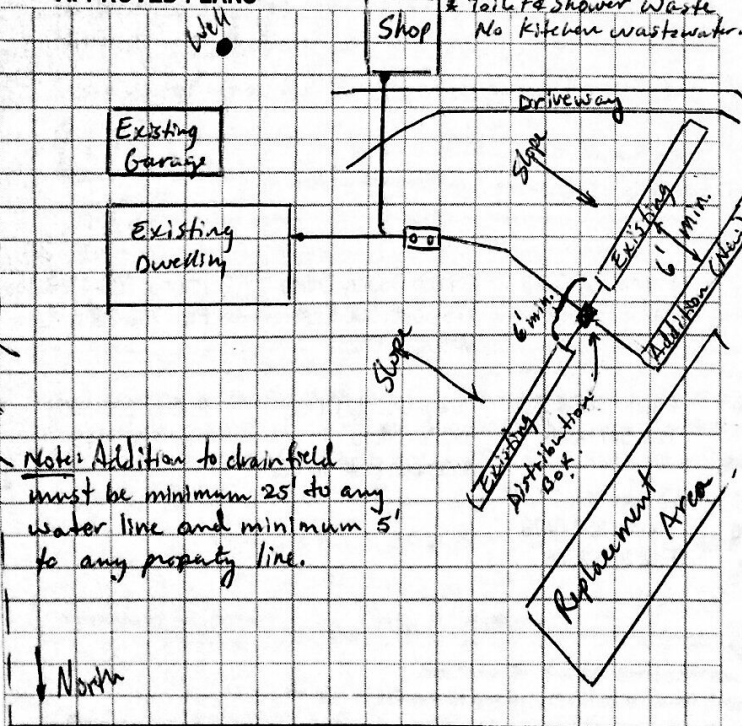

Moonlight Mine

To Pocatello →

Moonlight Mine.