

JURISDICTION  
 TRAVEL TIME: 45 (58) - 7/11/06  
 INSPECTION TIME: 60  
 1 office 30  
 Act 6/20/06

SOUTHEASTERN DISTRICT HEALTH DEPARTMENT  
 1901 ALVIN RICKEN DRIVE POCATELLO, ID 83201

1457 \$ 1215  
 FEE PD  Y  N  
 PERMIT # 166807

net 4434 Permit renewed 6/8/06

15106 APPLICATION AND PERMIT VALID FOR ONE YEAR FROM DATE OF ISSUANCE

NAME <b>TONY DAVIS</b>	PHONE <b>232-3221</b>	PROPERTY ADDRESS <b>4274 Buckskin, Pocatello 10 83201</b>
MAILING ADDRESS <b>7432 North Valley Vista</b>	LEGAL DESCRIPTION: LOT SIZE (ACRES) <b>30</b>	
STREET/P.O. BOX	1/4 SECTION <b>3E</b> SECTION <b>24</b> TOWNSHIP <b>6</b> RANGE <b>35</b>	
CITY <b>Pocatello</b>	LOT # _____ BLOCK # _____ SUBDIVISION _____	
STATE <b>Idaho</b>	ZIP <b>83201</b>	PARCEL # _____ FROM TAX ASSESSOR'S OFFICE
SEPTIC TANK SIZE <b>1500</b> gal.	EST TYPE <b>232</b>	EFFECTIVE DISPOSAL AREA <b>1333</b> SQ. FT.
	SOIL TYPE <b>C1</b>	MAXIMUM DEPTH BELOW GROUND SURFACE <b>4ft</b>
		# BEDROOMS <b>6</b>

INSTALLATION MUST BE BY LICENSED SEWER INSTALLER OR HOME/LANDOWNER

DATE <b>03/08/05</b>	EHS SIGNATURE <i>[Signature]</i>	EHS# <b>69</b>	APPLICANT SIGNATURE <i>[Signature]</i>
REMARKS <b>Must provide copy of warranty deed.</b>			

THE DISTRICT HEALTH DEPARTMENT SHALL BE NOTIFIED OF INSTALLATION 48 HOURS PRIOR TO BACKFILLING

SEPTIC TANK SIZE <b>2-1200 Snake River precast</b> gal.	STANDPIPE: ( ) YES (X) NO	MANHOLE DEPTH <b>2'</b>	DEPTH BELOW GROUND SURFACE <b>3'</b>	ROCK UNDER PIPE <b>75' Under 4, Infiltrators</b>
EFFECTIVE DISPOSAL AREA <b>1415</b> sq. ft.	INSTALLATION <b>APPROVED X</b> DISAPPROVED _____	INSTALLER <b>Rick's Power Wash 30904</b>		


EHS SIGNATURE <b>Ken Keller</b>	DATE <b>7/11/06</b>	CODE <b>G</b>	EHS # <b>58</b>
REMARKS <b>Shop is added, OK to put flow from Restroom in shop into system. Recommend that additional tank be added to serve shop, and enlarge drainfield.</b>			

WATER SYSTEM

PLANS APPROVED <b>YES X NO</b>	SAMPLE COLLECTED BY	DATE	STATE LAB INDICATES INTESTINAL BACTERIA WERE _____ WERE NOT _____ FOUND
MIN. DISTANCES PER STANDARDS/REGS. <b>YES X NO</b>	CHEMICAL PARAMETERS TESTED WITHIN LIMITS YES _____ NO _____		SYSTEM PUBLIC _____ PRIVATE <b>X</b>

WELL (SPRING) APPEARS TO MEET CONSTRUCTION STANDARDS AT TIME OF INSPECTION <b>(X) YES ( ) NO</b>	EHS SIGNATURE <b>Ken Keller</b>	EHS# <b>58</b>
REMARKS <b>Replacement drainfield is uphill from primary drainfield. Replacement area may need to be pumped to, or additional septic tanks installed uphill to allow gravity flow.</b>		

APPROVED PLANS

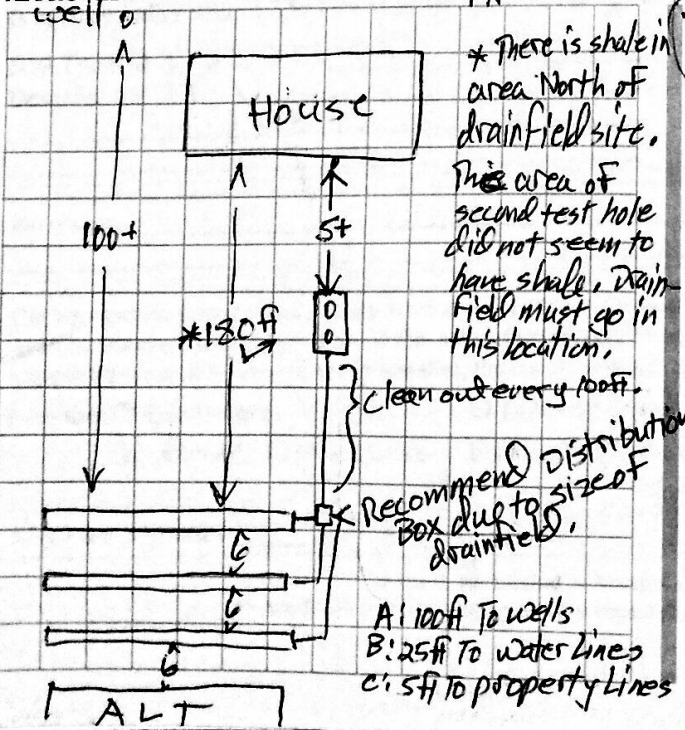

AS BUILT PLANS

