

SOUTHEASTERN DISTRICT HEALTH DEPARTMENT  
INDIVIDUAL SEWAGE DISPOSAL INSTALLATION PERMIT

Date 27 August 75

Permit No. \_\_\_\_\_ Installation for HARRY FURGERSON at 1/4 SEC. NW SECTION 24 T. 720 R. 35 E 8m  
(Name) (Legal description of property)  
Address of Installation 2.2 mi East Portneuf. Exit  
No. Living Units 1 Bedrooms 1 People Served 2 Water Supply—Private X Public \_\_\_\_\_ Applicant is: Owner X Contractor \_\_\_\_\_ Other \_\_\_\_\_  
FHA \_\_\_\_\_ FARM HOME \_\_\_\_\_ VA \_\_\_\_\_ CONV. X EXISTING \_\_\_\_\_ NO. \_\_\_\_\_

Septic Tank 1000 gal. Perc. Rate 30 Min./in. Min. Depth to Ground Water 60 ft.  
Effluent Disposal: Effective Area Required 300 sq. ft. Soil System: Sandy + dirt - gravel below that  
Field Drain X Absorption Bed \_\_\_\_\_ Standard X Modified \_\_\_\_\_ Seepage Pit \_\_\_\_\_ Dimensions \_\_\_\_\_

Distance from Disposal Area to:  
Property Lines: Front 2200 ft. Back 200 ft. Side 20 ft. Dwelling Foundation 20 ft. Well 130+ ft.  
Surface Water 60 ft. Nearest Neighbor's Well 500 ft. Plot Plan Submitted and Approved X Septic Tank \_\_\_\_\_ ft.

Remarks: \_\_\_\_\_  
Applicant HARRY FURGERSON Paid \_\_\_\_\_ Bill \_\_\_\_\_ No Fee X  
Address \_\_\_\_\_ Permit Issued by William H. Mailbauer

INSPECTION: Septic Tank Size \_\_\_\_\_ Standpipe \_\_\_\_\_ Depth to Manhole \_\_\_\_\_  
Distance from Septic Tank to: Dwelling Foundation \_\_\_\_\_ ft. Well \_\_\_\_\_ ft. Nearest Neighbor's Well \_\_\_\_\_ ft.  
Effluent Disposal: Effective Area \_\_\_\_\_ sq. ft.  
Field Drain \_\_\_\_\_ Absorption Bed \_\_\_\_\_ Standard \_\_\_\_\_ Modified \_\_\_\_\_ Seepage Pit \_\_\_\_\_ Dimensions \_\_\_\_\_  
Pipe Size \_\_\_\_\_ No. of Lines \_\_\_\_\_ Length \_\_\_\_\_ Depth \_\_\_\_\_


Distance from Disposal Area to:  
Property Lines: Front \_\_\_\_\_ ft. Back \_\_\_\_\_ ft. Side \_\_\_\_\_ ft. Dwelling Foundation \_\_\_\_\_ ft. Well \_\_\_\_\_ ft.  
Surface Water \_\_\_\_\_ ft. Water Service Piping \_\_\_\_\_ ft. Depth to Gravel \_\_\_\_\_ ft. Nearest Neighbor's Well \_\_\_\_\_ ft.  
Approved \_\_\_\_\_ Not Approved \_\_\_\_\_ Inspected 10 Oct 75 by H. Furgeson Installed by John Long  
(Date)

Remarks He used some pit gravel - 4' long in one trench

Applicant's sketch of house, proposed sewage layout and all adjacent wells (dimension between all components) --

See plot plan

~~320~~ 320 square feet.

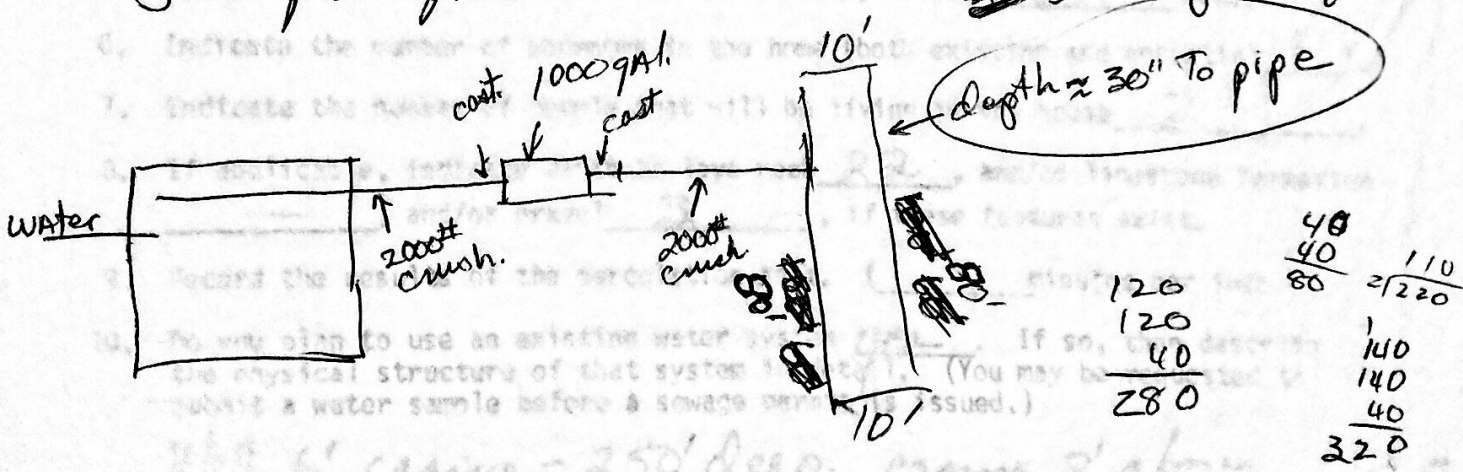

otherwise to be built according to