

JURISDICTION

05/08/03 *GW/GW*
300 69

SOUTHEASTERN DISTRICT HEALTH DEPARTMENT
1901 ALVIN RICKEN DRIVE POCATELLO, ID 83201

9780

FEE PD Y N
PERMIT # 161475

TRAVEL TIME: 45
INSPECTION TIME: 30

**APPLICATION AND PERMIT VALID FOR ONE YEAR FROM DATE OF ISSUANCE

NAME <i>Tim Abramson</i>		PHONE <i>775-3519</i>	PROPERTY ADDRESS <i>355 North Marsh Creek Road</i>		
MAILING ADDRESS <i>PO BOX 523</i>		LEGAL DESCRIPTION: LOT SIZE (ACRES) <i>46.5</i>			
STREET/P.O. BOX		1/4 SECTION <i>NW</i> SECTION <i>4</i> TOWNSHIP <i>7</i> RANGE <i>36</i>			
CITY <i>Inkom</i>		LOT # _____ BLOCK # _____ SUBDIVISION _____			
STATE <i>Idaho</i> ZIP <i>83205</i>		PARCEL # <i>R24015032000</i> FROM TAX ASSESSOR'S OFFICE			
SEPTIC TANK SIZE <i>1000</i> gal.	EST TYPE <i>232</i>	EFFECTIVE DISPOSAL AREA <i>667</i> SQ. FT.	SOIL TYPE <i>B2</i>	MAXIMUM DEPTH BELOW GROUND SURFACE <i>4ft</i>	# BEDROOMS <i>4</i>

INSTALLATION MUST BE BY LICENSED SEWER INSTALLER OR HOME/LANDOWNER

DATE <i>2/26/03</i>	EHS SIGNATURE <i>[Signature]</i>	EHS# <i>69</i>	APPLICANT SIGNATURE <i>[Signature]</i>
------------------------	-------------------------------------	-------------------	---

REMARKS *There is another sewer on this property supporting old home that burnt down in 2003.*

THE DISTRICT HEALTH DEPARTMENT SHALL BE NOTIFIED OF INSTALLATION 48 HOURS PRIOR TO BACKFILLING

SEPTIC TANK SIZE <i>1250</i> gal.	STANDPIPE: () YES <input checked="" type="checkbox"/> NO	MANHOLE DEPTH <i>12 inches</i>	DEPTH BELOW GROUND SURFACE <i>4ft</i>	ROCK UNDER PIPE <i>27 Infiltrators</i>
EFFECTIVE DISPOSAL AREA <i>667</i> sq. ft.	INSTALLATION APPROVED <input checked="" type="checkbox"/> DISAPPROVED _____	INSTALLER <i>Jason Holm</i> <i>243-4650</i> INSTALLER # <i>27984</i>		


EHS SIGNATURE <i>[Signature]</i>	DATE <i>05/08/03</i>	CODE <i>6</i>	EHS # <i>69</i>
-------------------------------------	-------------------------	------------------	--------------------

REMARKS *Measurements from home to Tank to Manhole.*

WATER SYSTEM

PLANS APPROVED YES <input checked="" type="checkbox"/> NO _____	SAMPLE COLLECTED BY _____	DATE _____	STATE LAB INDICATES INTESTINAL BACTERIA WERE _____ WERE NOT _____ FOUND
MIN. DISTANCES PER STANDARDS/REGS. YES <input checked="" type="checkbox"/> NO _____	CHEMICAL PARAMETERS TESTED WITHIN LIMITS YES _____ NO _____	SYSTEM PUBLIC _____ PRIVATE <input checked="" type="checkbox"/>	
WELL (SPRING) APPEARS TO MEET CONSTRUCTION STANDARDS AT TIME OF INSPECTION <input checked="" type="checkbox"/> YES () NO <i>Existing well</i>	EHS SIGNATURE <i>[Signature]</i>		EHS # <i>69</i>
REMARKS <i>water line not installed.</i>			

APPROVED PLANS

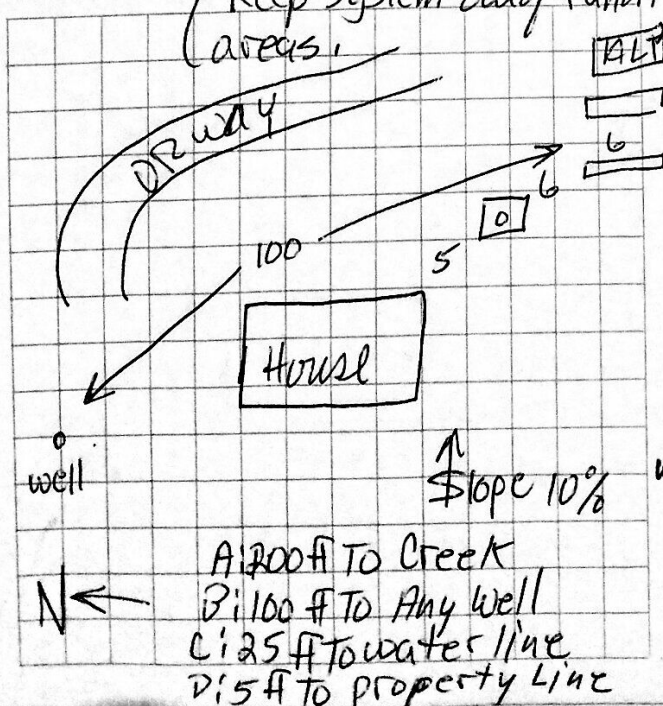

AS BUILT PLANS

