

SOUTHEASTERN DISTRICT HEALTH DEPARTMENT  
INDIVIDUAL SEWAGE DISPOSAL INSTALLATION PERMIT

Permit No. \_\_\_\_\_ Date 17 June 1975  
Installation for Raymond Girard at NE 1/4 SW 1/4 NW 1/4 SE 1/4 Sec 15 T8 S R36E  
(Name) (Legal description of property)

Address of Installation \_\_\_\_\_  
No. Living Units 1 Bedrooms 3 People Served 4 Water Supply—Private  Public \_\_\_\_\_  
FHA \_\_\_\_\_ FARM HOME \_\_\_\_\_ VA \_\_\_\_\_ CONV. \_\_\_\_\_ EXISTING \_\_\_\_\_ NO. \_\_\_\_\_  
Applicant is: Owner  Contractor \_\_\_\_\_ Other \_\_\_\_\_

Septic Tank 1000 gal. Perc. Rate 30 Min./in. Min. Depth to Ground Water \_\_\_\_\_ ft.  
Effluent Disposal: Effective Area Required 750 sq. ft. Soil System: \_\_\_\_\_ Soil Profile \_\_\_\_\_  
Field Drain  Absorption Bed  Standard \_\_\_\_\_ Modified \_\_\_\_\_ Seepage Pit \_\_\_\_\_ Dimensions \_\_\_\_\_

Distance from Disposal Area to:  
Property Lines: Front 10 ft. Back 10 ft. Side 10 ft. Dwelling Foundation 20 ft. Well 100 ft.  
Surface Water 150 ft. Nearest Neighbor's Well 100 ft. Plot Plan Submitted and Approved \_\_\_\_\_ Septic Tank 5 ft.

Remarks: Have disposal system approved and inspected before backfilling  
Applicant Raymond Girard Paid \_\_\_\_\_ Bill \_\_\_\_\_ No Fee

Address \_\_\_\_\_ Permit Issued by William H. Mathews


INSPECTION: Septic Tank Size 1000 Standpipe N.A. Depth to Manhole 18"  
Distance from Septic Tank to: Dwelling Foundation \_\_\_\_\_ ft. Well \_\_\_\_\_ ft. Nearest Neighbor's Well \_\_\_\_\_ ft.

Effluent Disposal: Effective Area 675 sq. ft.  
Field Drain  Absorption Bed \_\_\_\_\_ Standard \_\_\_\_\_ Modified \_\_\_\_\_ Seepage Pit \_\_\_\_\_ Dimensions \_\_\_\_\_  
Pipe Size 4" No. of Lines 3 Length 85 Depth 2 1/2

Distance from Disposal Area to:  
Property Lines: Front \_\_\_\_\_ ft. Back \_\_\_\_\_ ft. Side \_\_\_\_\_ ft. Dwelling Foundation \_\_\_\_\_ ft. Well \_\_\_\_\_ ft.  
Surface Water \_\_\_\_\_ ft. Water Service Piping \_\_\_\_\_ ft. Depth to Gravel \_\_\_\_\_ ft. Nearest Neighbor's Well \_\_\_\_\_ ft.

Approved  Not Approved \_\_\_\_\_ Inspected 12 Nov 75 W. H. Mathews Installed by Dale Mathews  
(Date)

Remarks Much of this system was installed in a gravel-dirt area  
therefore this system was approved on this basis with less  
Applicant's sketch of house, proposed sewage layout and all adjacent wells (dimension between all components) — effective area

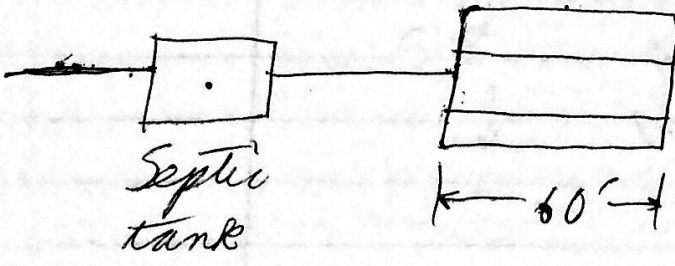

Trenches 3' wide, bottom of pipe no deeper than 3' below ground surface. 6' ft of undisturbed dirt between trenches, and trenches 60' long, all inter-connected.