

JURISDICTION 252104 69 2900 69 **SOUTHEASTERN DISTRICT HEALTH DEPARTMENT**
 1901 ALVIN RICKEN DRIVE POCATELLO, ID 83201 Act. 8507
 FEE PD X Y N
 PERMIT # 165607

TRAVEL TIME: 60
 INSPECTION TIME: 45

****APPLICATION AND PERMIT VALID FOR ONE YEAR FROM DATE OF ISSUANCE**

NAME <u>Barney & Linda Lewis</u>		PHONE <u>232-5905</u>	PROPERTY ADDRESS <u>3837 Wright Lane</u>	
MAILING ADDRESS		LEGAL DESCRIPTION: LOT SIZE (ACRES) <u>2 Acres +</u>		
STREET/P.O. BOX <u>1256 E Whitman</u>		1/4 SECTION	SECTION <u>16</u>	TOWNSHIP <u>9</u> RANGE <u>34</u>
CITY <u>Pocatello</u>	LOT #		BLOCK #	SUBDIVISION
STATE <u>ID</u>	ZIP <u>83201</u>	PARCEL # <u>RPD 1872-02</u>		FROM TAX ASSESSOR'S OFFICE
SEPTIC TANK SIZE <u>1000 gal.</u>	EST TYPE <u>232</u>	EFFECTIVE DISPOSAL AREA <u>556 SQ. FT.</u>	SOIL TYPE <u>B-2</u>	MAXIMUM DEPTH BELOW GROUND SURFACE <u>4'</u>
				# BEDROOMS <u>3</u>

INSTALLATION MUST BE BY LICENSED SEWER INSTALLER OR HOME/LANDOWNER

DATE <u>5/20/2004</u>	EHS SIGNATURE <u>Craig Madson</u>	EHS# <u>65</u>	APPLICANT SIGNATURE <u>Barney Lewis</u>
REMARKS			

INSPECTION


THE DISTRICT HEALTH DEPARTMENT SHALL BE NOTIFIED OF INSTALLATION 48 HOURS PRIOR TO BACKFILLING

SEPTIC TANK SIZE <u>1000 gal.</u>	STANDPIPE: () YES (X) NO	MANHOLE DEPTH <u>18 inches</u>	DEPTH BELOW GROUND SURFACE <u>3 1/2</u>	ROCK UNDER PIPE <u>20 Infiltrators</u>
EFFECTIVE DISPOSAL AREA <u>592 sq. ft.</u>	INSTALLATION APPROVED <input checked="" type="checkbox"/> DISAPPROVED <input type="checkbox"/>	INSTALLER <u>Greg Olson</u>	INSTALLER # <u>22322</u>	
EHS SIGNATURE <u>[Signature]</u>	DATE <u>05/21/04</u>	CODE <u>B</u>	EHS # <u>69</u>	
REMARKS <u>Pump tank every 3 years. Don't landscape over system.</u>				

WATER SYSTEM

PLANS APPROVED YES <input checked="" type="checkbox"/> NO <input type="checkbox"/>	SAMPLE COLLECTED BY	DATE	STATE LAB INDICATES INTESTINAL BACTERIA WERE <input type="checkbox"/> WERE NOT <input type="checkbox"/> FOUND
MIN. DISTANCES PER STANDARDS/REGS. YES <input checked="" type="checkbox"/> NO <input type="checkbox"/>	CHEMICAL PARAMETERS TESTED WITHIN LIMITS YES <input type="checkbox"/> NO <input type="checkbox"/>		SYSTEM PUBLIC <input type="checkbox"/> PRIVATE <input checked="" type="checkbox"/>
WELL (SPRING) APPEARS TO MEET CONSTRUCTION STANDARDS AT TIME OF INSPECTION (<input checked="" type="checkbox"/> YES () NO	EHS SIGNATURE <u>Cm</u>		EHS#
REMARKS			

APPROVED PLANS

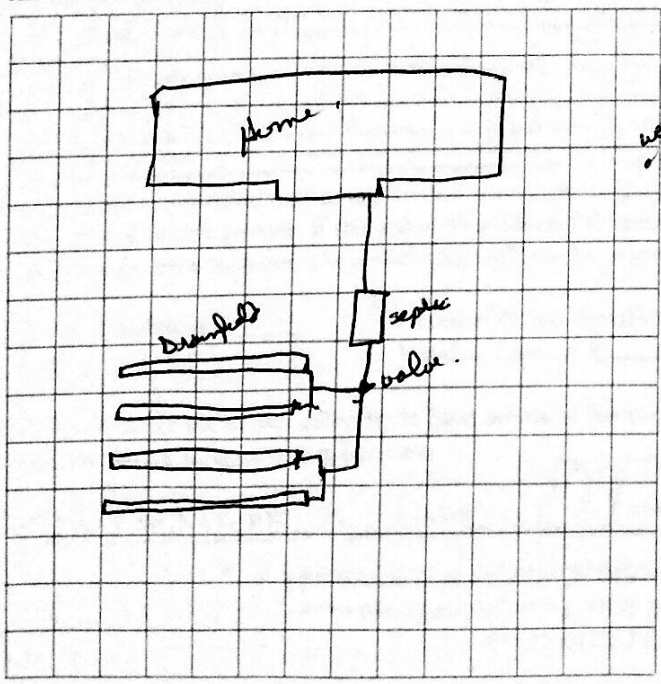

AS BUILT PLANS

