

Jurisdiction  
300

Call flow

Southeastern District Health Department

Receipt # 4437  
Fee PD  Y  N  
Permit # 169760

EHS # 58  
Date 8/21/07  
Travel Time 90  
Inspection Time 60

APPLICATION & PERMIT VALID FOR ONE YEAR FROM DATE OF ISSUANCE

Exp. Date 6/15/2007

Name Phil Adams Phone 801 624 5474 Property Address Garden Creek, 6790 W. Garden Cr. Rd, Arimo, ID 83214  
 Mailing Address \_\_\_\_\_ Legal Description: Lot Size (Acres) 1.60  
 Street/P.O. Box P.O. Box 150310 1/4 Section \_\_\_\_\_ Section 22 Township 9 South Range 35 East  
 City Ogden Lot # \_\_\_\_\_ Block # \_\_\_\_\_ Subdivision \_\_\_\_\_  
 State Utah Zip 84415 Parcel # \_\_\_\_\_ From Tax Assessor's Office

Septic Tank Size 1000 gal. Est. Type 232 Effective Disposal Area 1000 Sq. Ft. Soil Type C-1 Maximum Depth Below Ground Surface 4' # Bedrooms 4

INSTALLATION MUST BE BY LICENSED SEWER INSTALLER OR HOME/LANDOWNER

Date 6/15/06 EHS Signature Ken Keller EHS # 58 Applicant Signature [Signature]  
 Remarks Drainfield and replacement area must be minimum 100' from dug well. Septic tank must be minimum 50' from any well. Drainfield must be min. 25' from any water line.

INSPECTION


THE DISTRICT HEALTH DEPARTMENT SHALL BE NOTIFIED OF INSTALLATION 48 HOURS PRIOR TO BACKFILLING

Septic Tank Size 1500 gal. Pscatello precast Standpipe Y X N Manhole Depth at grade Depth Below Ground Surface 4' Rock Under Pipe 54 Quick 4" Infiltrators  
 Effective Disposal Area 1018 sq. ft. Code G INSTALLATION APPROVED X DISAPPROVED \_\_\_\_\_ Installer Bob McKee Const. Installer # 22578  
 EHS Signature Ken Keller Date 8/21/07 EHS # 58  
 Remarks Recommend your septic tank be pumped at least every 3 years.

WATER SYSTEM

Min. Distances Per Regs.  
 From Septic System Y X N Water System Public  Private   
 Remarks Property lines are greater than 5' to drain field. Well is much greater than 100' to drain field.

APPROVED PLANS

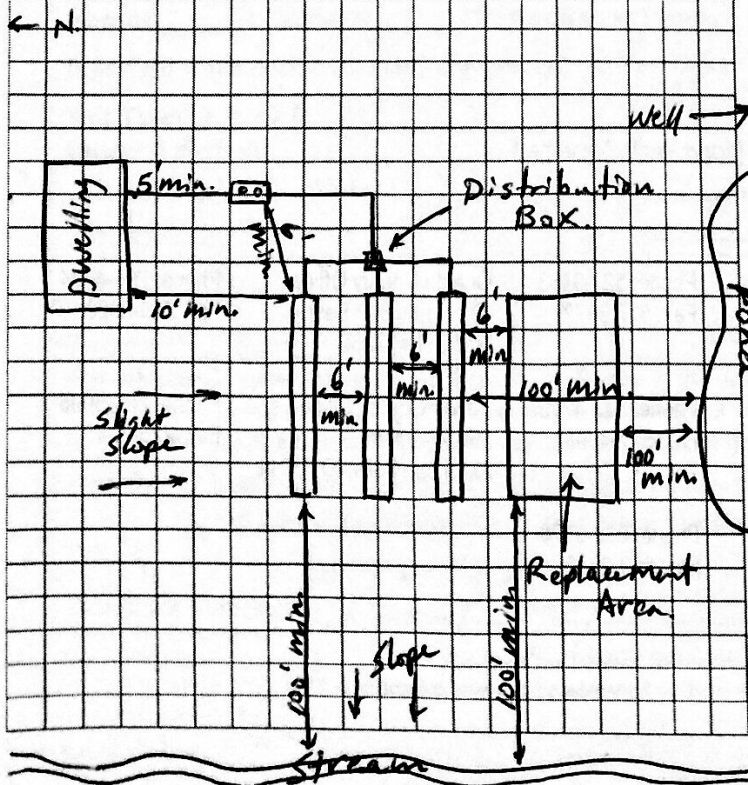

AS BUILT PLANS

