

10/14/03

GW/low

(9797 Receipt # For \$40.00)
REF # 8763 J#1459

JURISDICTION
300

69 SOUTHEASTERN DISTRICT HEALTH DEPARTMENT
1901 ALVIN RICKEN DRIVE POCATELLO, ID 83201

FEE PD Y N
PERMIT # 156183

TRAVEL TIME: 60
INSPECTION TIME: 45

**APPLICATION AND PERMIT VALID FOR ONE YEAR FROM DATE OF ISSUANCE

NAME G. KEVIN PHILLIPS		PHONE 208 747-3488	PROPERTY ADDRESS 8246 W. Wald (approx) GARDEN CREEK RD		
MAILING ADDRESS: 1352N. 4000 W.		LEGAL DESCRIPTION: LOT SIZE (ACRES) _____			
STREET/P.O. BOX		1/4 SECTION ^{SE 1/4} SECTION 20 TOWNSHIP 9S RANGE 3SE.			
CITY DAYTON		LOT # _____ BLOCK # _____ SUBDIVISION _____			
STATE ID		ZIP 83232		PARCEL # R 4221008500 FROM TAX ASSESSOR'S OFFICE	
SEPTIC TANK SIZE 1000 gal.	EST TYPE 232	EFFECTIVE DISPOSAL AREA 500 SQ.FT.	SOIL TYPE C1	MAXIMUM DEPTH BELOW GROUND SURFACE 4	# BEDROOMS N/A

INSTALLATION MUST BE BY LICENSED SEWER INSTALLER OR HOME/LANDOWNER

EHS SIGNATURE <i>[Signature]</i>	EHS # 55	APPLICANT SIGNATURE <i>[Signature]</i>	DATE 10/12/01
-------------------------------------	-------------	---	------------------

REMARKS ~~Install~~ Permit Renewed until 10/12/03.

INSPECTION

THE DISTRICT HEALTH DEPARTMENT SHALL BE NOTIFIED OF INSTALLATION 48 HOURS PRIOR TO BACKFILLING


SEPTIC TANK SIZE 1000 gal ^{the cast}	STANDPIPE: () YES (X) NO	MANHOLE DEPTH 13 inches	DEPTH BELOW GROUND SURFACE 4A	ROCK UNDER PIPE 23 Infiltrators
EFFECTIVE DISPOSAL AREA 1607 sq. ft.	INSTALLATION APPROVED <input checked="" type="checkbox"/> DISAPPROVED _____	INSTALLER self		

EHS SIGNATURE <i>[Signature]</i>	DATE 10/14/03	CODE 6	EHS # 69
REMARKS Mr. Phillips says he operated backhoe.			

WATER SYSTEM

PLANS APPROVED YES <input checked="" type="checkbox"/> NO _____	SAMPLE COLLECTED BY _____	DATE _____	STATE LAB INDICATES INTESTINAL BACTERIA WERE _____ WERE NOT FOUND
MIN. DISTANCES PER STANDARDS/REGS. YES <input checked="" type="checkbox"/> NO _____	CHEMICAL PARAMETERS TESTED WITHIN LIMITS YES _____ NO _____		SYSTEM PUBLIC _____ PRIVATE _____
WELL (SPRING) APPEARS TO MEET CONSTRUCTION STANDARDS AT TIME OF INSPECTION (X) YES () NO	EHS SIGNATURE <i>[Signature]</i>		EHS # 69
REMARKS			

APPROVED PLANS

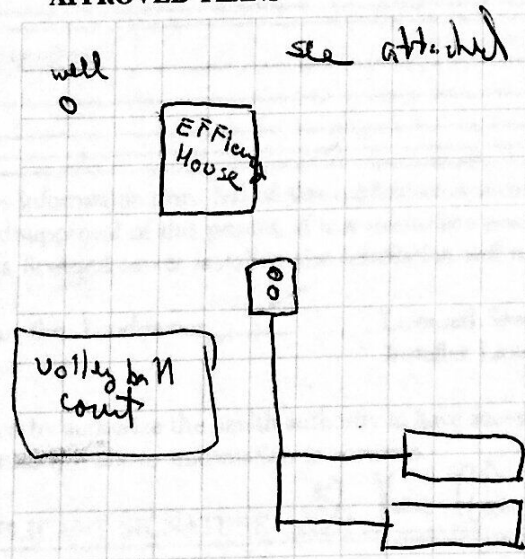

AS BUILT PLANS

