

#232-5579

WATER AND SEWER PERMIT

SE District Health Department

PLANNING & ZONING APPROVAL

| | | |
|--|---|--|
| Name Richard A. Clouse | Phone 232-5579 | Property Address 1430 Juniper Hill Rd |
| Address 1430 Juniper Hill Rd | Legal Description T7S R34E Sect. 22 | |
| Report To Replacement system | Funding <input type="checkbox"/> Governmental <input type="checkbox"/> Individual | <input type="checkbox"/> Conventional <input type="checkbox"/> Existing Loan No. |

SEWAGE SYSTEM

Installation shall comply with all requirements of Health District and/or State of Idaho sewage disposal rules, regulations and standards

| | | | | |
|---|---|---|--|---------------------------------|
| No. Bedrooms 3 | Septic Tank 1000 gal. | Disposal Area 300 sq. ft. | TYPE <input checked="" type="checkbox"/> Trench <input type="checkbox"/> Pit <input type="checkbox"/> Sand Filter <input type="checkbox"/> Bed <input type="checkbox"/> E.T. <input type="checkbox"/> Modified | Permit No. 3122 |
| Dimensions | Maximum Depth below Ground Surface 5 feet | PLOT PLAN <input checked="" type="checkbox"/> Approved <input type="checkbox"/> Disapproved | By Earl Mandell | Permit Fee \$30.00 |
| Remarks Replacement system (replace tank too) | Applicant's Signature X [Signature] | | Date 9/13/85 | Permit Fee \$30.00 ck |

INSPECTION

The District Health Department shall be notified of installation **48 hrs** prior to installation **backfill**


| | | | | | | |
|---|--|---|---|---------------------------|---|------------------------------|
| SEPTIC TANK Size 1000 gal. | STANDPIPE <input checked="" type="checkbox"/> Yes <input type="checkbox"/> No | Manhole Depth 24" | DEPTH OF Ground Water | Bedrock >12' | Gravel >12' | Rock Under Pipe 6" |
| Minimum Distances as per Regulations <input type="checkbox"/> Yes <input type="checkbox"/> No | Approved Aggregate <input checked="" type="checkbox"/> Yes <input type="checkbox"/> No | Effective Disposal Area 546 sq. ft. | Installed By Richard Browning | | | |
| EXISTING SYSTEM Appears to meet Standards/Regs <input type="checkbox"/> Yes <input type="checkbox"/> No | INSTALLATION <input checked="" type="checkbox"/> Approved <input type="checkbox"/> Disapproved | By X [Signature] | | Date 10/4/85 | Remarks Approved pending installation of a cleanout manhole. Manhole ext. (not completely) sealed to septic tank. 233-0279 - R Browning - no cleanout required. [Signature] | |

WATER SYSTEM

| | | | | |
|--|---|--|---|------------|
| Plans Approved <input type="checkbox"/> Yes <input type="checkbox"/> No | State Laboratory indicates intestinal bacteria <input type="checkbox"/> were <input type="checkbox"/> were not found in water. | Sample Collected By | Date | Permit Fee |
| Min. Distances as per Standards/Regs <input type="checkbox"/> Yes <input type="checkbox"/> No | CHEMICAL TOLERANCES Acceptable Limits <input type="checkbox"/> Yes <input type="checkbox"/> No <input type="checkbox"/> Not Chk'd | System <input type="checkbox"/> Public <input type="checkbox"/> Private | Complies with Health Dist. and/or State of Idaho Standards/Regs <input type="checkbox"/> Yes <input type="checkbox"/> No | |
| Existing System appears to comply with all requirements of Health Dist. and State of Idaho Drinking Water Standards/Regs <input type="checkbox"/> Yes <input type="checkbox"/> No | INSTALLATION <input type="checkbox"/> Approved <input type="checkbox"/> Disapproved | By X | Date | |
| Remarks | | | | Permit Fee |

DIAGRAM

X Where applicable, diagram shall include orientation of components of water and sewage systems

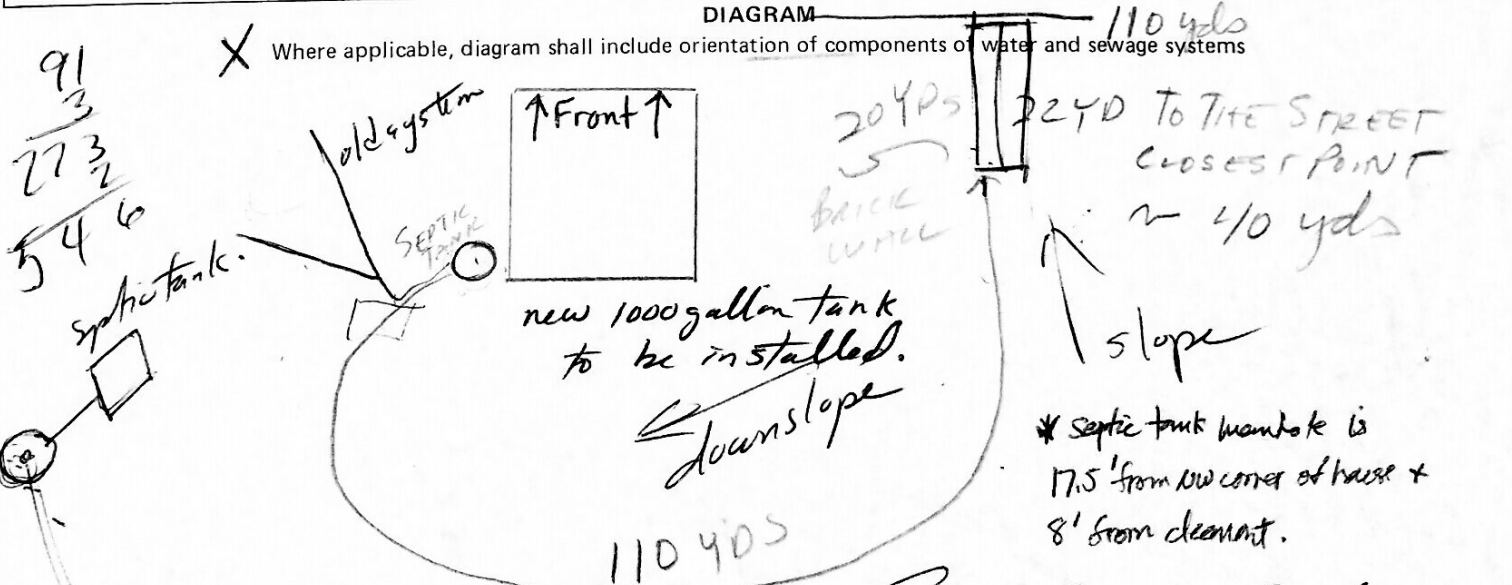

old 500 gallon septic tank is not approved for use. Replace and fill old tank with soil. Ramp to be installed IAW exposure proof standards.