

SOUTHEASTERN DISTRICT HEALTH DEPARTMENT
465 MEMORIAL DRIVE POCATELLO, ID

EXEMPT FROM FEE
FEE PD Y N
PERMIT # 87149

JURISDICTION 390

TRAVEL TIME: _____
INSPECTION TIME: _____

RENEWED TO 8/6/95

***APPLICATION AND PERMIT VALID FOR ONE YEAR FROM DATE OF ISSUANCE

NAME <u>ROSS PARK/CITY OF POC</u>		PHONE <u>234-6196</u>	PROPERTY ADDRESS <u>2900 So. 2nd AVENUE</u>	
MAILING ADDRESS:		LEGAL DESCRIPTION: LOT SIZE (ACRES) <u>7 1/2</u>		
STREET/PO BOX <u>ROSS PARK GARDENS</u>		1/4 SECTION <u>NE</u>	SECTION <u>1</u>	TOWNSHIP <u>75</u> RANGE <u>34</u>
CITY <u>902 E SHERMAN</u>		LOT # _____	BLOCK # _____	SUBDIVISION <u>CITY OF POCATELLO</u>
STATE <u>POCATELLO, ID</u> ZIP _____		PARCEL # <u>NA</u> FROM TAX ASSESSOR'S OFFICE		
SEPTIC TANK SIZE <u>1000</u> gal.	EST TYPE <u>232</u>	EFFECTIVE DISPOSAL AREA <u>500</u> SQ. FT.	SOIL TYPE <u>B2</u>	MAXIMUM DEPTH BELOW GROUND SURFACE <u>2'</u> # BEDROOMS <u>6</u> EMPLOYEES <u>6</u>

INSTALLATION MUST BE BY LICENSED SEWER INSTALLER OR HOME/LANDOWNER

EHS SIGNATURE <u>[Signature]</u>	EHS # <u>61</u>	APPLICANT SIGNATURE <u>[Signature]</u>	DATE <u>8/6/95</u>
REMARKS <u>NEED CAP-FILL SYSTEM DUE TO BEDROCK</u>			

INSPECTION

THE DISTRICT HEALTH DEPARTMENT SHALL BE NOTIFIED OF INSTALLATION 48 HOURS PRIOR TO INSTALLATION

SEPTIC TANK SIZE _____ gal.	STANDPIPE: () YES () NO	MANHOLE DEPTH _____	DEPTH BELOW GROUND SURFACE _____	ROCK UNDER PIPE _____
EFFECTIVE DISPOSAL AREA _____ SQ. FT.	INSTALLATION APPROVED _____ DISAPPROVED _____	INSTALLER _____		INSTALLER # _____


EHS SIGNATURE _____	DATE _____	EHS # _____
REMARKS _____		

WATER SYSTEM

PLANS APPROVED YES _____ NO _____	SAMPLE COLLECTED BY _____	DATE _____	STATE LAB INDICATES INTESTINAL BACTERIA WERE _____ WERE NOT _____ FOUND
MIN. DISTANCES PER STANDARDS/REGS YES _____ NO _____	CHEMICAL PARAMETERS TESTED _____ WITHIN LIMITS YES _____ NO _____		SYSTEM PUBLIC _____ PRIVATE _____
WELL (SPRING) APPEARS TO MEET CONSTRUCTION STANDARDS AT TIME OF INSPECTION () YES () NO	EHS SIGNATURE _____		EHS # _____
REMARKS _____			

APPROVED PLANS

AS BUILT PLANS

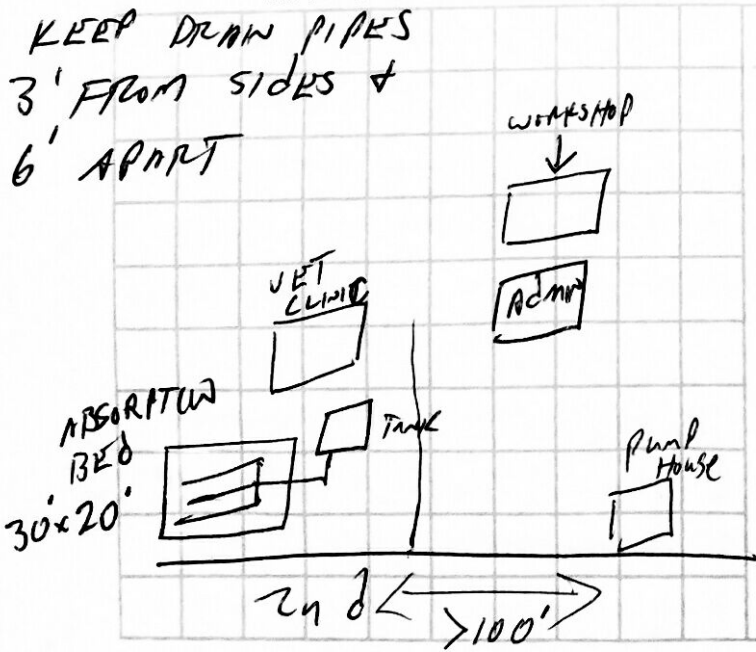

Permit expired if installed was not inspected