

JURISDICTION
0390
TRAVEL TIME: 15
INSPECTION TIME: 30

SOUTHEASTERN DISTRICT HEALTH DEPARTMENT
465 MEMORIAL DRIVE POCATELLO, ID

GW, LHM
FEE PD Y N
PERMIT # 17962

***APPLICATION AND PERMIT VALID FOR ONE YEAR FROM DATE OF ISSUANCE

NAME Thomas, John & Nancy		PHONE 234-1742	PROPERTY ADDRESS Field Dr. Pocatello off Johnny Creek		
MAILING ADDRESS: 227 So. 7th		LEGAL DESCRIPTION: LOT SIZE (ACRES) 5.33			
CITY Pocatello		1/4 SECTION NE 1/4 SECTION 12 TOWNSHIP 7S RANGE 34E			
STATE Id		LOT # _____ BLOCK # _____ SUBDIVISION _____			
ZIP 83201		PARCEL # RPOPP125202 FROM TAX ASSESSOR'S OFFICE			
SEPTIC TANK SIZE 1000 gal.	EST TYPE S. Fam	EFFECTIVE DISPOSAL AREA 556 SQ. FT.	SOIL TYPE B2	MAXIMUM DEPTH BELOW GROUND SURFACE 4'	# BEDROOMS 3

INSTALLATION MUST BE BY LICENSED SEWER INSTALLER OR HOME/LANDOWNER

EHS SIGNATURE Craig Madison	EHS # 65	APPLICANT SIGNATURE Den Coffin	DATE 8/5/93
REMARKS			

INSPECTION


THE DISTRICT HEALTH DEPARTMENT SHALL BE NOTIFIED OF INSTALLATION 48 HOURS PRIOR TO INSTALLATION

SEPTIC TANK SIZE 1000 gal.	STANDPIPE: () YES (X) NO	MANHOLE DEPTH 1" level	DEPTH BELOW GROUND SURFACE 2-3'	ROCK UNDER PIPE 6"
EFFECTIVE DISPOSAL AREA 629 SQ. FT.	INSTALLATION APPROVED <input checked="" type="checkbox"/>	DISAPPROVED	INSTALLER Frasure Const.	INSTALLER # 891
EHS SIGNATURE Steven J. R...	DATE 10-8-93	EHS # 64	REMARKS	

WATER SYSTEM

PLANS APPROVED YES _____ NO _____	SAMPLE COLLECTED BY	DATE	STATE LAB INDICATES INTESTINAL BACTERIA WERE _____ WERE NOT _____ FOUND
MIN. DISTANCES PER STANDARDS/REGS YES _____ NO _____	CHEMICAL PARAMETERS TESTED WITHIN LIMITS YES _____ NO _____		SYSTEM PUBLIC <input checked="" type="checkbox"/> PRIVATE _____
WELL (SPRING) APPEARS TO MEET CONSTRUCTION STANDARDS AT TIME OF INSPECTION () YES () NO	EHS SIGNATURE		EHS #
REMARKS City of Pocatello Water			

APPROVED PLANS

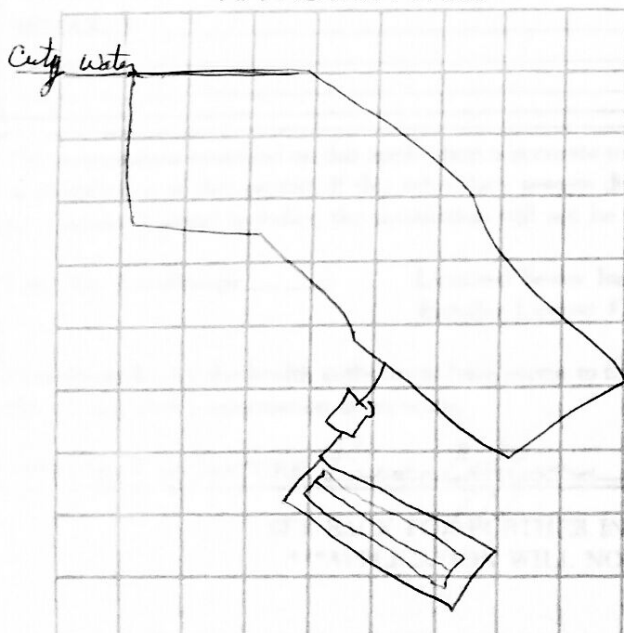

AS BUILT PLANS

