

will call me Thur. morn

T75, R 34E, Sec 13

SOUTHEASTERN DISTRICT HEALTH DEPARTMENT
INDIVIDUAL SEWAGE DISPOSAL INSTALLATION PERMIT

DATE 5-11-71

INSTALLATION FOR H. Wayne Schow AT Johnny Creek
236-2768 (name) (location, lot & blk. or street)


TOTAL NUMBER 1
Living Units/ Bedrooms/ People Served 1/1/1
Septic Tank 1000 gal. Seepage Pit Field Drain Modified Field Drain
Absorption Bed

FHA VA CONV WATER SUPPLY
NEW EXISTING (Public/Private)
Field Drain Modified Field Drain

Make or Dimensions 1/2 lane Square Footage (effective area) 680 sq ft
Based on perc test results of 10 min/inch fall - I.D.H. Bulletin # 6 spec

DISTANCE OF INSTALLATION FROM
Property Lines: front ft. back ft. side 12 ft. well 12 ft.
canals or ditches ft.
Foundation 5 ft. Nearest adjacent well ft. Special construction conditions

Paid Bill No fee
APPLICANT H. Wayne Schow
Signature

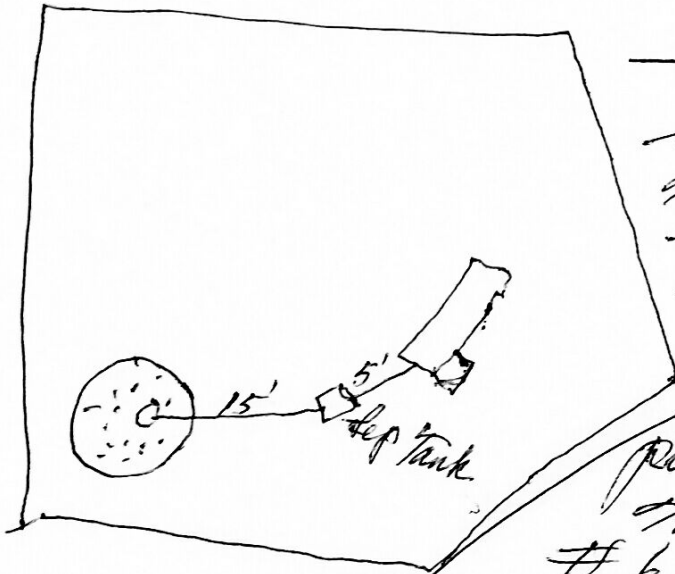

Address
Seepage Pit Design:
To be min. of 15' X 16' deep & low
inlet and backfill around 4' circles
block core & approved material,
use 4" cast iron pipe
between septic tank & seepage
pit to span wide.
To be constructed / Bulletin
6 Idaho Code - spec

INSPECTED 5/27/71 BY Joren Tolman
date sanitarian
APPROVED NOT APPROVED

Plan Approved
Paul Cleaver

see back