

JURISDICTION

390

01/05/00

SOUTHEASTERN DISTRICT HEALTH DEPARTMENT  
1901 ALVIN RICKEN DRIVE POCATELLO, ID 83201

GW, GW

42374 receipt #

FEE PD 152 Y N  
PERMIT # 141359

TRAVEL TIME: 30  
INSPECTION TIME: 45

\*\*APPLICATION AND PERMIT VALID FOR ONE YEAR FROM DATE OF ISSUANCE

NAME Donald D. Brown		PHONE 232-8568	PROPERTY ADDRESS 4285 Bannock Hwy		
MAILING ADDRESS: 4285 Bannock Hwy		LEGAL DESCRIPTION: LOT SIZE (ACRES) 6 1/4 SECTION East SECTION 12 TOWNSHIP 7 RANGE 34			
STREET/P.O. BOX		LOT # _____ BLOCK # _____ SUBDIVISION _____			
CITY Pocatello		PARCEL # RCPPP122900 FROM TAX ASSESSOR'S OFFICE			
STATE IDAHO		ZIP 83204			
SEPTIC TANK SIZE 900 gal.	EST TYPE 233	EFFECTIVE DISPOSAL AREA 444 SQ.FT.	SOIL TYPE B2	MAXIMUM DEPTH BELOW GROUND SURFACE Replacement	# BEDROOMS 2

INSTALLATION MUST BE BY LICENSED SEWER INSTALLER OR HOME/LANDOWNER

EHS SIGNATURE <i>[Signature]</i>	EHS # 69	APPLICANT SIGNATURE Donald D. Brown	DATE 12/23/99
-------------------------------------	-------------	--	------------------

REMARKS Letter From City is attached

INSPECTION

THE DISTRICT HEALTH DEPARTMENT SHALL BE NOTIFIED OF INSTALLATION 48 HOURS PRIOR TO BACKFILLING

SEPTIC TANK SIZE 1000 gal Prex cast	STANDPIPE: ( ) YES (X) NO	MANHOLE DEPTH 18 in	DEPTH BELOW GROUND SURFACE 4 1/4	ROCK UNDER PIPE 15 in, Armatose
EFFECTIVE DISPOSAL AREA 444 sq. ft.	INSTALLATION APPROVED <input checked="" type="checkbox"/> DISAPPROVED _____	INSTALLER S & J	INSTALLER # 903	

EHS SIGNATURE <i>[Signature]</i>	DATE 01/05/00	CODE 6	EHS # 69
-------------------------------------	------------------	-----------	-------------


REMARKS

WATER SYSTEM

PLANS APPROVED YES <input checked="" type="checkbox"/> NO _____	SAMPLE COLLECTED BY	DATE	STATE LAB INDICATES INTESTINAL BACTERIA WERE _____ WERE NOT _____ FOUND
MIN. DISTANCES PER STANDARDS/REGS. YES <input checked="" type="checkbox"/> NO _____	CHEMICAL PARAMETERS TESTED WITHIN LIMITS YES _____ NO _____		SYSTEM PUBLIC <input checked="" type="checkbox"/> PRIVATE _____
WELL (SPRING) APPEARS TO MEET CONSTRUCTION STANDARDS AT TIME OF INSPECTION ( ) YES ( ) NO	EHS SIGNATURE _____ EHS # _____		

REMARKS Pocatello City water supplied

APPROVED PLANS

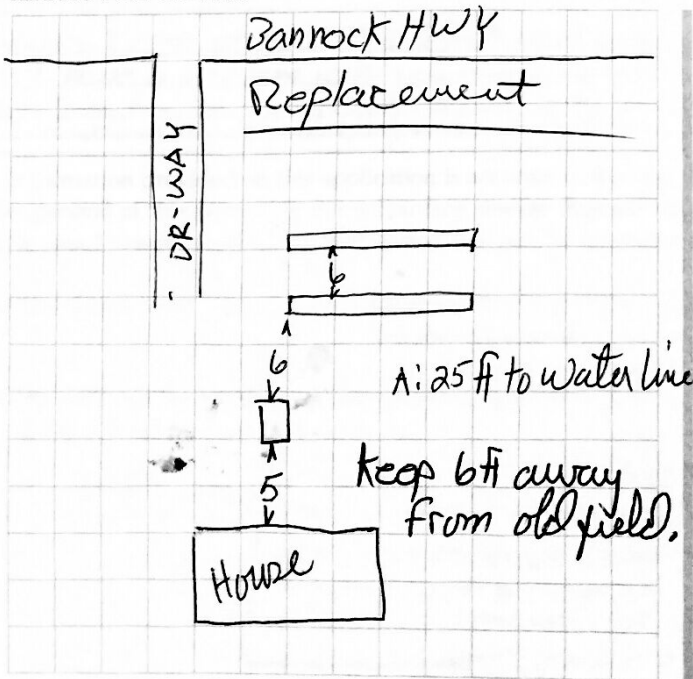

AS BUILT PLANS

