

RECEIVED SEP 13 2001

Exempt

JURISDICTION 300

SOUTHEASTERN DISTRICT HEALTH DEPARTMENT
1901 ALVIN RICKEN DRIVE POCATELLO, ID 83201

FEE PD Y X N
PERMIT # 155661

TRAVEL TIME: 60
INSPECTION TIME: 30

Non Conforming

**APPLICATION AND PERMIT VALID FOR ONE YEAR FROM DATE OF ISSUANCE

NAME Pocatello Police Relief		PHONE 234-6100	PROPERTY ADDRESS Grandview		
MAILING ADDRESS: PO BOX 4163		LEGAL DESCRIPTION: LOT SIZE (ACRES)			
STREET/P.O. BOX		1/4 SECTION	SECTION 2	TOWNSHIP	RANGE 34
CITY Pocatello		LOT #	BLOCK #	SUBDIVISION	
STATE Idaho		ZIP 83206		PARCEL # No Parcel # for this lot FROM TAX ASSESSOR'S OFFICE RPPDPI 22700	
SEPTIC TANK SIZE None gal.	EST TYPE 233	EFFECTIVE DISPOSAL AREA 60 SQ.FT.	SOIL TYPE B2	MAXIMUM DEPTH BELOW GROUND SURFACE 4ft	# BEDROOMS 0

INSTALLATION MUST BE BY LICENSED SEWER INSTALLER OR HOME/LANDOWNER

EHS SIGNATURE <i>[Signature]</i>	EHS # 69	APPLICANT SIGNATURE Paul Manning	DATE 08/30/01
-------------------------------------	-------------	-------------------------------------	------------------

REMARKS May use 2 Infiltrators. No Tank required. This is a gray water system.


INSPECTION THE DISTRICT HEALTH DEPARTMENT SHALL BE NOTIFIED OF INSTALLATION 48 HOURS PRIOR TO BACKFILLING					
SEPTIC TANK SIZE None gal	STANDPIPE: () YES (X) NO	MANHOLE DEPTH NA	DEPTH BELOW GROUND SURFACE 2ft	ROCK UNDER PIPE 2 Infiltrators	
EFFECTIVE DISPOSAL AREA 60 sq. ft.	INSTALLATION APPROVED X	DISAPPROVED	INSTALLER Jim Estel	INSTALLER # 903	

EHS SIGNATURE <i>[Signature]</i>	DATE 08/31/01	CODE S	EHS # 69
-------------------------------------	------------------	-----------	-------------

REMARKS Creek not flowing at this time.

WATER SYSTEM			
PLANS APPROVED YES X NO	SAMPLE COLLECTED BY	DATE	STATE LAB INDICATES INTESTINAL BACTERIA WERE WERE NOT FOUND
MIN. DISTANCES PER STANDARDS/REGS. YES NO	CHEMICAL PARAMETERS TESTED WITHIN LIMITS YES NO	SYSTEM None	PUBLIC PRIVATE
WELL (SPRING) APPEARS TO MEET CONSTRUCTION STANDARDS AT TIME OF INSPECTION () YES () NO	EHS SIGNATURE EHS #		
REMARKS			

APPROVED PLANS

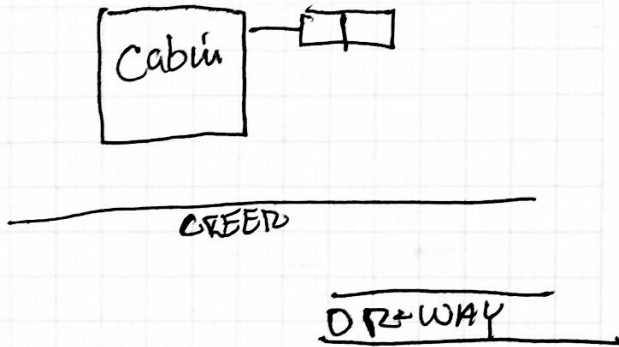

AS BUILT PLANS

