

T6S, R34E, Sec 9

SOUTHEASTERN DISTRICT HEALTH DEPARTMENT
INDIVIDUAL SEWAGE DISPOSAL INSTALLATION PERMIT


DATE 12-6-66

INSTALLATION FOR R.R. Price AT Quinn 1/2 mile East of Philbin
(name) (location, lot & blk. or street)

TOTAL NUMBER 1 2 5
Living Units/Bedrooms/People Served
Septic Tank 1000 gal. Seepage Pit Field Drain Modified Field Drain Absorption Bed
FHA VA CONV WATER SUPPLY
NEW EXISTING Public/Private
Make or Dimensions _____ Square Footage (effective area) _____

DISTANCE OF INSTALLATION FROM
Property Lines: front 70 ft. back 200 ft. side 50 ft. well 150 ft. canals or ditches none ft.
Foundation 30 ft. Nearest adjacent well 150 ft. Special construction conditions _____
Paid Bill _____ No fee _____

APPLICANT R.R. Price
Signature
Lot #2 Box 311
Address

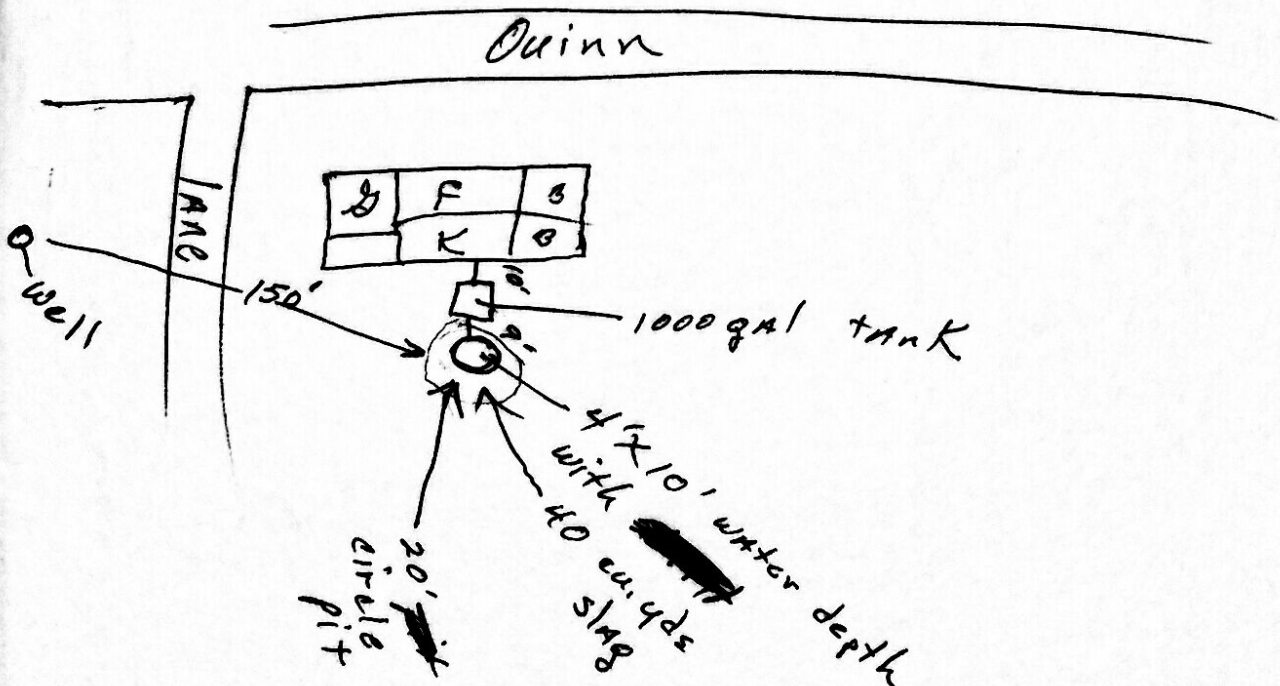

INSPECTED 1-12-67 BY Rulon S. Tuller
date sanitarian

APPROVED NOT APPROVED

Plan Approved
Rulon S. Tuller