

T6S R34E Sec 4

SOUTHEASTERN DISTRICT HEALTH DEPARTMENT
INDIVIDUAL SEWAGE DISPOSAL INSTALLATION PERMIT

DATE 10-5-66

INSTALLATION FOR Murray Payne AT W. Chubbuck Rd.
(name) (location, lot & blk. or street)


TOTAL NUMBER 3 FHA VA CONV WATER SUPPLY
Living Units / Bedrooms / People Served NEW EXISTING Public Private
Septic Tank 1000 gal. Seepage Pit Field Drain Modified Field Drain
3 1/2 concrete Absorption Bed
Make or Dimensions Square Footage (effective area) 375 - 700 sqft.

DISTANCE OF INSTALLATION FROM
Property Lines: front ___ ft. back ___ ft. side 30 ft. well ___ ft.
canals or ditches ___ ft.
Foundation 10 ft. Nearest adjacent well ___ ft. Special construction conditions ___

Paid Bill 8-11-67 No fee ___

APPLICANT M. Payne Signature
145 Northgate Address

Seepage pit Design:
15' diameter by 10' deep
below inlet. Backfill
w/ crushed rock, slag etc.
(about 40 cu yds)
make a 4' diam. circles
blk core w/ concrete
lid as described in
Bulletin 6 - Idaho code.
Stand blks on edge -
not on side as shown.
Installation & materials
shall meet standards
of Bulletin 6 Idaho code.

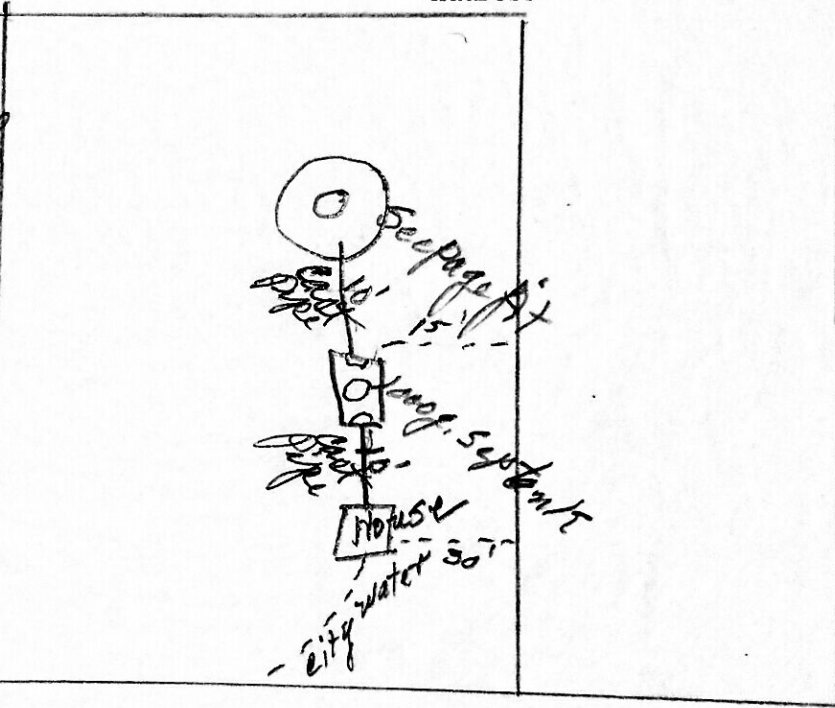

CHUBBUCK

INSPECTED 10-17-66 BY Paul Cleaver
date sanitarian
APPROVED NOT APPROVED Plan Approved

Paul Cleaver

HAWTHORNE CPA