

Now owned by Hansen - Feb 1977

SOUTHEASTERN DISTRICT HEALTH DEPARTMENT  
INDIVIDUAL SEWAGE DISPOSAL INSTALLATION PERMIT


DATE 9-22-67

INSTALLATION FOR Mrs Ernest Kiala AT Rt. 1 No. Philbin Rd. P.O. Box 51  
(name) (location, lot & blk. or street)

TOTAL NUMBER 2 4 FHA  VA  CONV  WATER SUPPLY   
Living Units/ Bedrooms/ People Served NEW  EXISTING  Public/Private   
Septic Tank 1000 gal. Seepage Pit  Field Drain  Modified Field Drain   
Absorption Bed   
Make or Dimensions \_\_\_\_\_ Square Footage (effective area) \_\_\_\_\_

DISTANCE OF INSTALLATION FROM  
Property Lines: front 50 ft. back 100 ft. side 100 ft. well 100 ft. canals or ditches \_\_\_\_\_ ft.  
Foundation 10 ft. Nearest adjacent well 100 ft. Special construction conditions good gravel  
Paid  Bill \_\_\_\_\_ No fee \_\_\_\_\_

APPLICANT Mrs Ernest J. Kiala  
Signature  
Rt. 1 no. Box 51  
Address  
Sec 4 T 6 R 34

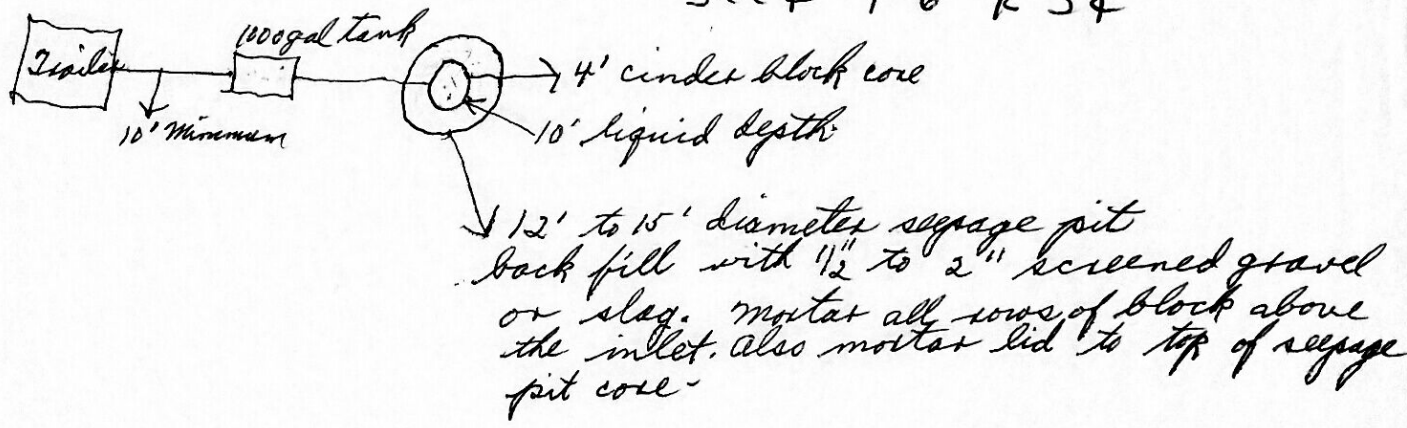

INSPECTED 9-27-67 BY Rulon S. Juelles  
date sanitarian

APPROVED  NOT APPROVED  Plan Approved  
Rulon S. Juelles