

T6S, R34E, Sec 5

SOUTHEASTERN DISTRICT HEALTH DEPARTMENT
INDIVIDUAL SEWAGE DISPOSAL INSTALLATION PERMIT

DATE 11/13/67

INSTALLATION FOR Norbert Darrel Smith AT Rio Vista Road 1/4 mile N. of Chubbuck Rd.
(name) (location, lot & blk. or street)

| | | | | | |
|--|---|---|---|---|--------------|
| TOTAL NUMBER | | FHA <input type="checkbox"/> | VA <input type="checkbox"/> | CONV <input type="checkbox"/> | WATER SUPPLY |
| Living Units/ Bedrooms/ People Served | | NEW <input checked="" type="checkbox"/> | EXISTING <input type="checkbox"/> | Public/Private | |
| Septic Tank <u>1000</u> gal. | Seepage Pit <input checked="" type="checkbox"/> | Field Drain <input type="checkbox"/> | Modified Field Drain <input type="checkbox"/> | Absorption Bed <input type="checkbox"/> | |
| Make or Dimensions <u>8'x4'x7 1/2'</u> Square Footage (effective area) | | <u>Approximately 400 sq. ft.</u> | | | |

DISTANCE OF INSTALLATION FROM

Property Lines: front 0 ft. back ft. side 10 ft. well 120 ft.
canals or ditches ft.


Foundation ft. Nearest adjacent well ft. Special construction conditions

Paid pd Bill No fee

APPLICANT Norbert Darrel Smith
Signature

1331 Yellowstone
Address

There are to be five (5) separate sewer systems constructed like this, each one will be serving two (2) mobile homes.

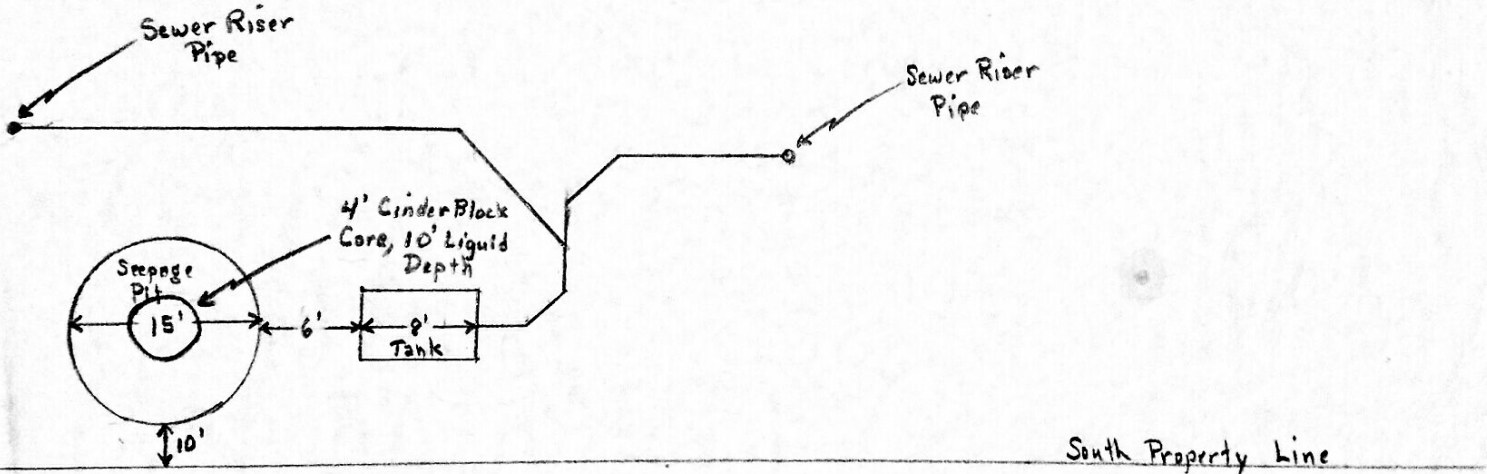

INSPECTED 4-9-68 BY Rulon S. Tuelker
date sanitary

APPROVED NOT APPROVED

Plan Approved

Rulon S. Tuelker