

T6S R34E Sec 35  
SE 1/4 SE 1/2 06

SOUTHEASTERN DISTRICT HEALTH DEPARTMENT  
INDIVIDUAL SEWAGE DISPOSAL INSTALLATION PERMIT

DATE 7/9/69


INSTALLATION FOR Wm Brewster AT So Grant Court  
(name) (location, lot & blk. or street)

1 3 4  
TOTAL NUMBER  
Living Units/Bedrooms/People Served  
Septic Tank 1000 gal. Seepage Pit  Field Drain  Modified Field Drain   
Absorption Bed   
FHA  VA  CONV  WATER SUPPLY  
NEW  EXISTING  Public/Private  
Make or Dimensions \_\_\_\_\_ Square Footage (effective area) \_\_\_\_\_

DISTANCE OF INSTALLATION FROM  
Property Lines: front 50 ft. back \_\_\_\_\_ ft. side 30 ft. well 100 ft.  
canals or ditches \_\_\_\_\_ ft.  
Foundation \_\_\_\_\_ ft. Nearest adjacent well \_\_\_\_\_ ft. Special construction conditions see below

Paid \_\_\_\_\_ Bill \_\_\_\_\_ No fee \_\_\_\_\_

APPLICANT Wm Brewster  
Signature  
755 So. 4th  
Address

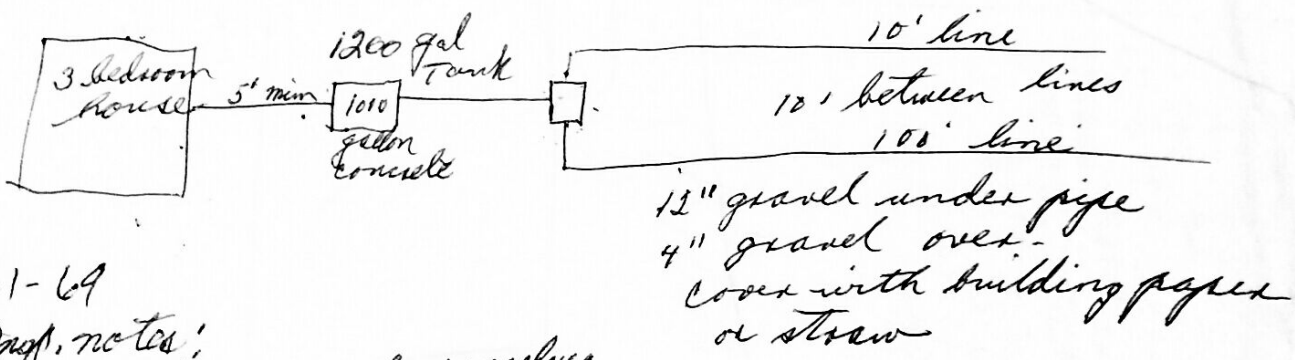

7-21-69

Inspr. notes:  
Drain field lines are of orangeburg  
& 4 ft. deep. Top of ground is to be  
graded down one foot & gravel to  
be filled to within 2 ft. of top.

INSPECTED 7-21-69 BY Paul Cleaver  
date sanitarian

APPROVED  NOT APPROVED

Plan Approved  
Rulon S. Tweller