

T6 834 Dec 10

SOUTHEASTERN DISTRICT HEALTH DEPARTMENT  
INDIVIDUAL SEWAGE DISPOSAL INSTALLATION PERMIT


DATE Oct. 15-1970

INSTALLATION FOR Billa Coin - Automatic AT Yellowstone & Chubbuck Road  
(name) (location, lot & blk. or street)

TOTAL NUMBER Service Station FHA  VA  CONV  WATER SUPPLY  
Living Units/ Bedrooms/ People Served NEW  EXISTING   Public/Private  
Septic Tank 1000 gal. Seepage Pit  Field Drain  Modified Field Drain   
Absorption Bed   
Make or Dimensions \_\_\_\_\_ Square Footage (effective area) \_\_\_\_\_

DISTANCE OF INSTALLATION FROM  
Property Lines: front 25 ft. back 10 ft. side 35 ft. well \_\_\_\_\_ ft.  
canals or ditches \_\_\_\_\_ ft.  
Foundation 30 ft. Nearest adjacent well  ft. Special construction conditions \_\_\_\_\_  
Paid \_\_\_\_\_ Bill \_\_\_\_\_ No fee \_\_\_\_\_

APPLICANT Carl A. Pylton  
Signature  
1908 No. Main St.  
Address

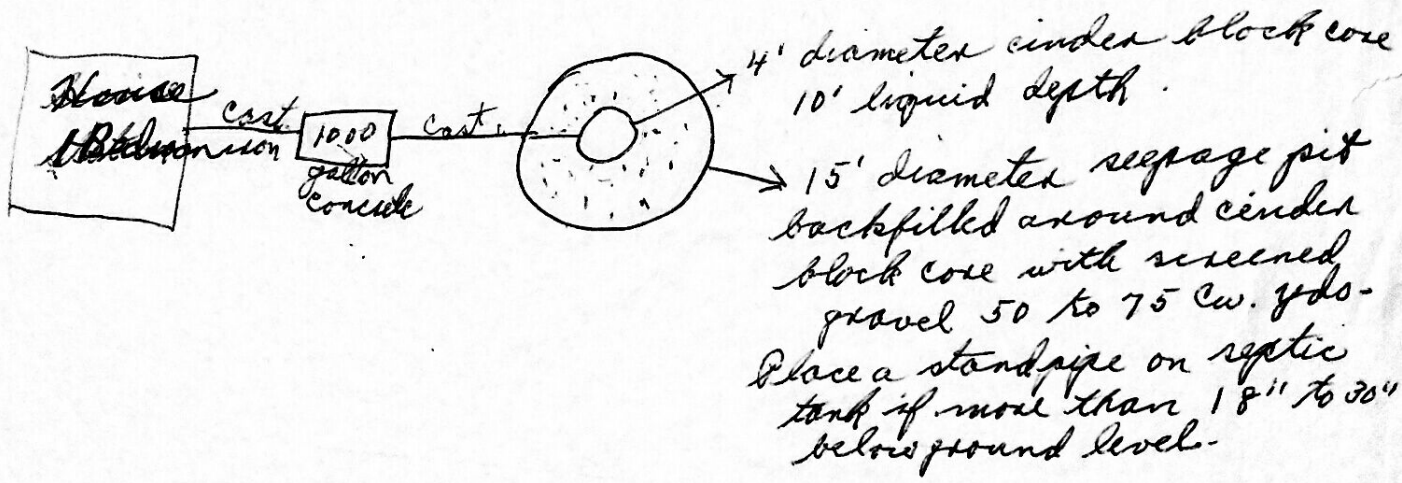

INSPECTED Oct. 19-1970 BY Rulon S. Jueller  
date sanitary

APPROVED  NOT APPROVED

Plan Approved  
Rulon S. Jueller