

T6S R34E Sec 5

SOUTHEASTERN DISTRICT HEALTH DEPARTMENT  
INDIVIDUAL SEWAGE DISPOSAL INSTALLATION PERMIT

K-D Trailer Park

DATE 5/25/70


INSTALLATION FOR Norbert Daniel Smith AT Rio Vista Rd 1/4 mile N. of Chubbuck Rd  
(name) (location, lot & blk. or street)

TOTAL NUMBER \_\_\_\_\_ FHA  VA  CONV  WATER SUPPLY \_\_\_\_\_  
6 Living Units/Bedrooms/People Served NEW  EXISTING  Public/Private \_\_\_\_\_  
Septic Tank 4800 gal. Seepage Pit  Field Drain  Modified Field Drain   
Absorption Bed   
Make or Dimensions 8'x16'x6' Square Footage (effective area) 4' core, 10' depth, 15' hole

DISTANCE OF INSTALLATION FROM  
Property Lines: front 80 ft. back 240 ft. side 104 ft. well 250 ft.  
canals or ditches \_\_\_\_\_ ft.  
Foundation \_\_\_\_\_ ft. Nearest adjacent well \_\_\_\_\_ ft. Special construction conditions \_\_\_\_\_

Paid  Bill \_\_\_\_\_ No fee \_\_\_\_\_

APPLICANT Norbert Daniel Smith  
Signature  
Rio Vista Rd Box 100  
Address

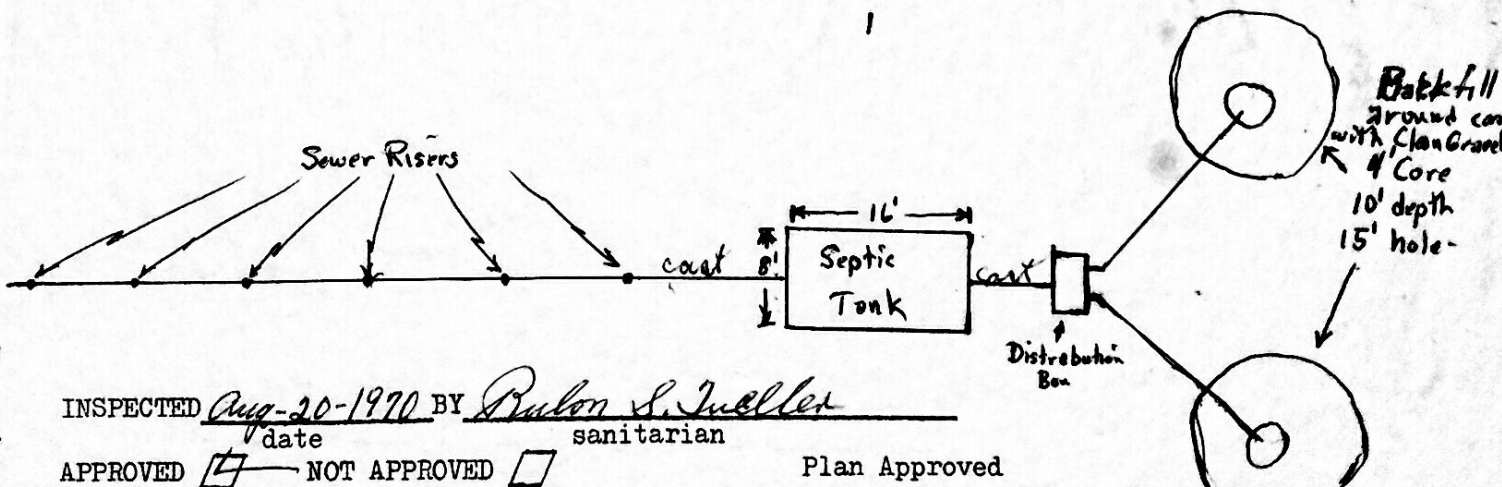

INSPECTED Aug-20-1970 BY Rulon S. Juelles  
date sanitarian

APPROVED  NOT APPROVED

Plan Approved

Rulon S. Juelles